27673
36376

T. 34S. R.9E. W.M.

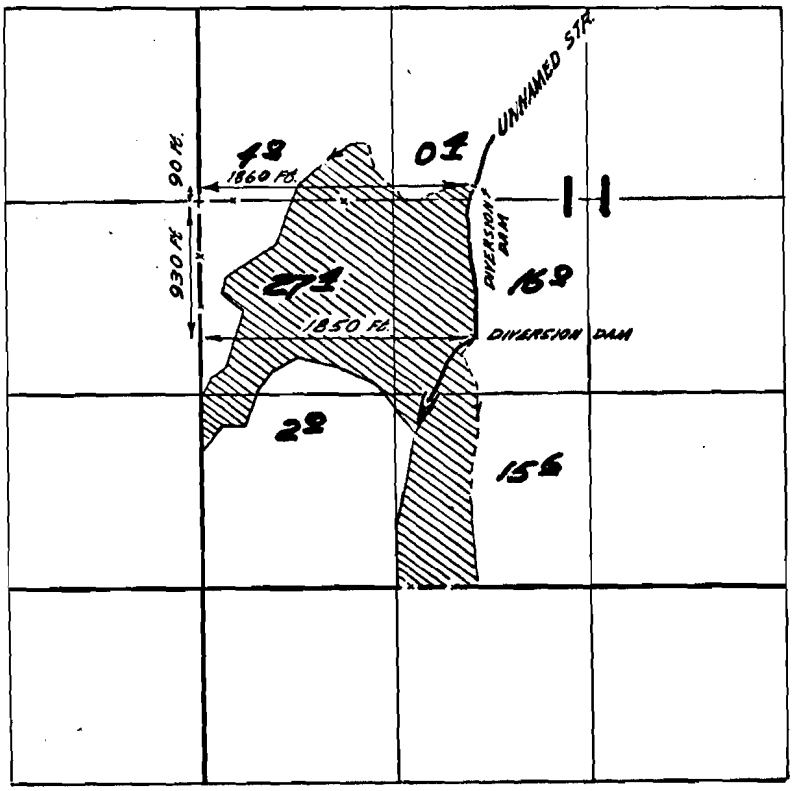

Sprague Rs. misc.

FINAL PROOF SURVEY
UNDER

Application No. 37150 Permit No. 27673
IN NAME OF
DAYTON O. & GERDA Y. HYDE

Surveyed August 21 1968, by W. A. Ruppert

1968-A