


29424  
36378

# T.34S. R.8&9E.W.M.

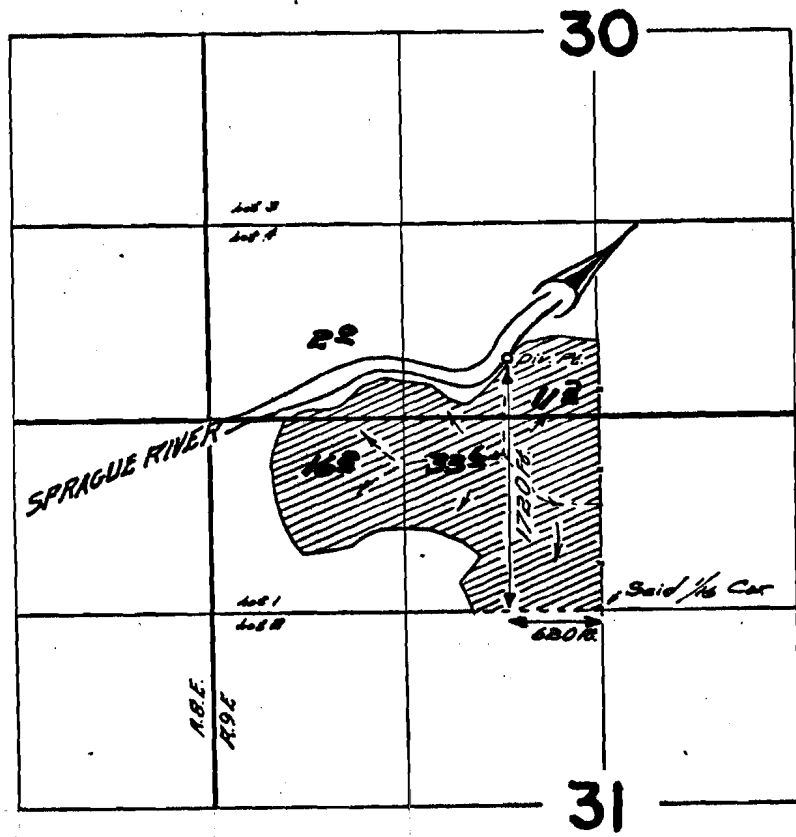

## FINAL PROOF SURVEY UNDER

Application No. 39591 Permit No. 29424  
IN NAME OF

EARL M. HARRIS

Surveyed August 23 1968, by H. D. Bopp