


31944
36379

T. 35S. R. 7E. W.M.

Williamson R. below Klamath Marsh

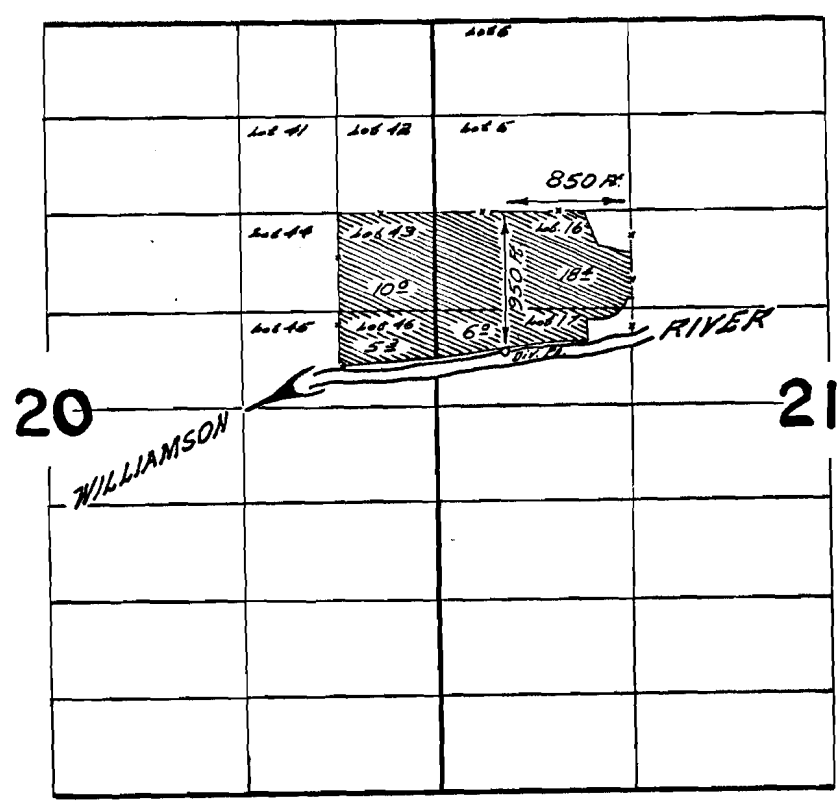

FINAL PROOF SURVEY UNDER

Application No. 12586... Permit No. 31944
IN NAME OF

GERTRUDE DI ULIO

Surveyed August 29 1968, by W. J. Ruppert