T. 16 S. R. 4 E. W.M.

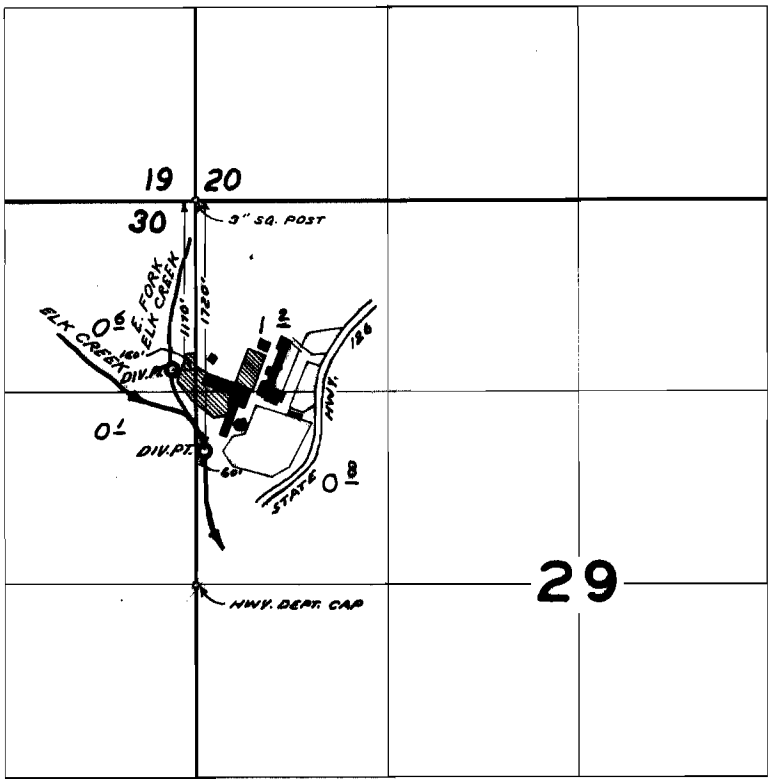

FINAL PROOF SURVEY
UNDER

Application No. 93686 Permit No. 26629
IN NAME OF

McKENZIE RIVER SCHOOLS, DIST. NO. 68

Surveyed SEP. 1 1966, by L. GOULD
Inspected SEP. 11 1968, by R.H. Jackson

1366-V ORB