


T. 17S. R. 1 E. W. M.

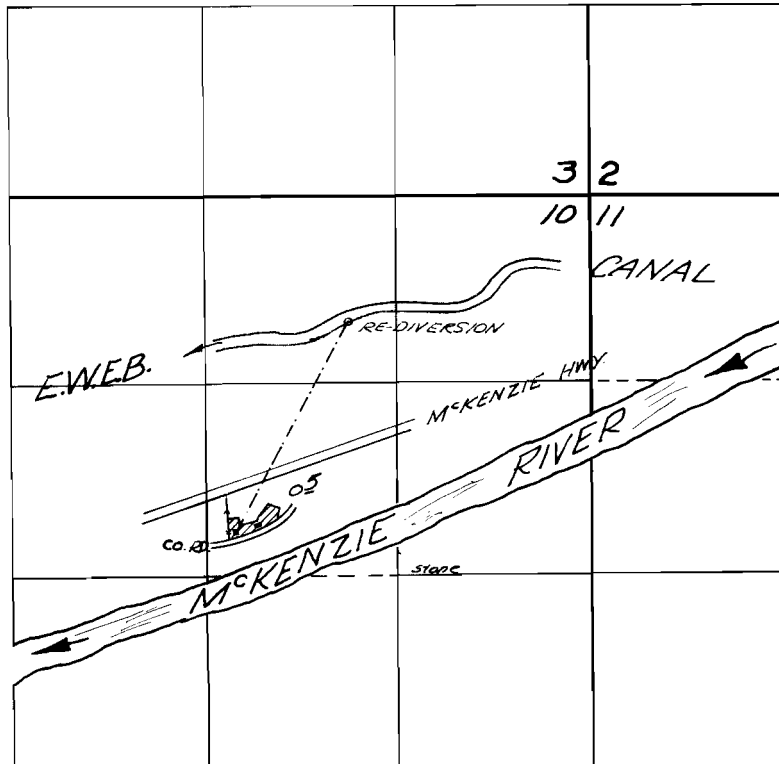

RE-DIVERSION LOCATED: - 1720 FT. N. & 330 FT. W. FROM THE CENTER OF SECTION 10

FINAL PROOF SURVEY UNDER

Application No. 37383 Permit No. 27826
IN NAME OF

EDWARD W. LARSEN

Surveyed June 16, 1967, by V. Gardner