


T. 19 S. R. 1 W. W. M.

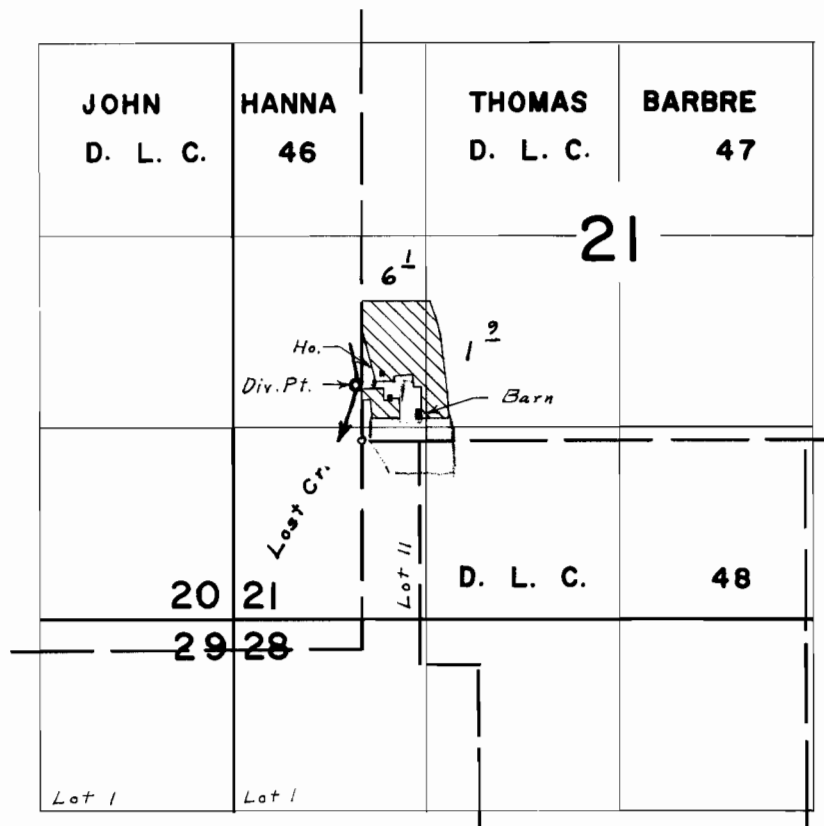

Div. Pt. located 380' N. & 30' W. from S.W. cor. Barbre D.L.C. 47

FINAL PROOF SURVEY UNDER

Application No. 41930 Permit No. 31408
IN NAME OF
DARYL B. HOBER

Surveyed NOV. 7, 1968, by W. J. Ruppert