


T.I.O.S. R.I.O.W.W.M.

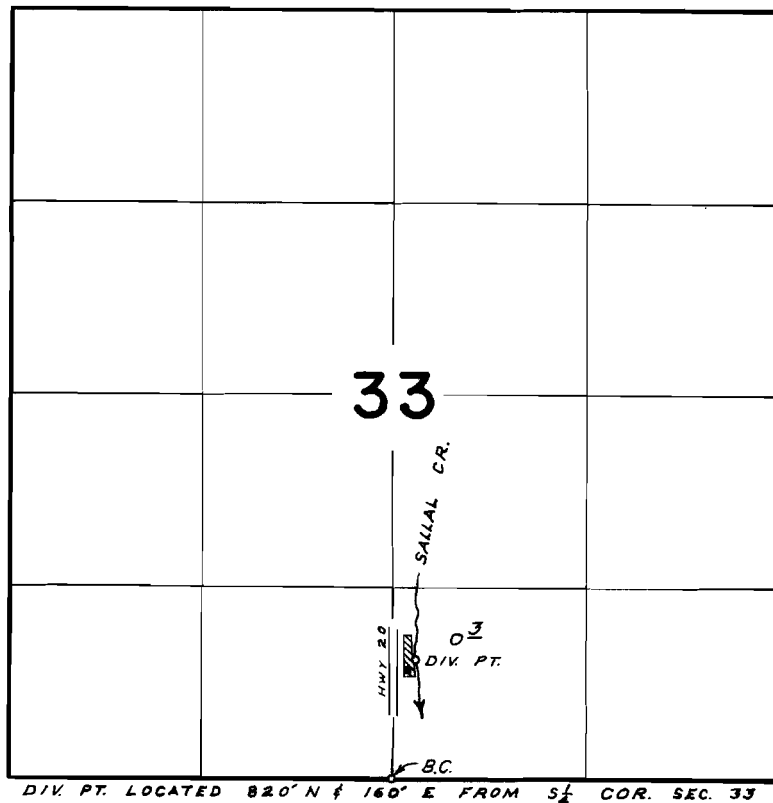

FINAL PROOF SURVEY
UNDER

Application No. **39909** Permit No. **29969**
IN NAME OF

JACOB M. SWINNEY

Surveyed **OCT. 2** 1968, by **W. J. RUPPERT**