


# T. 6S. R. 10W. W.M.

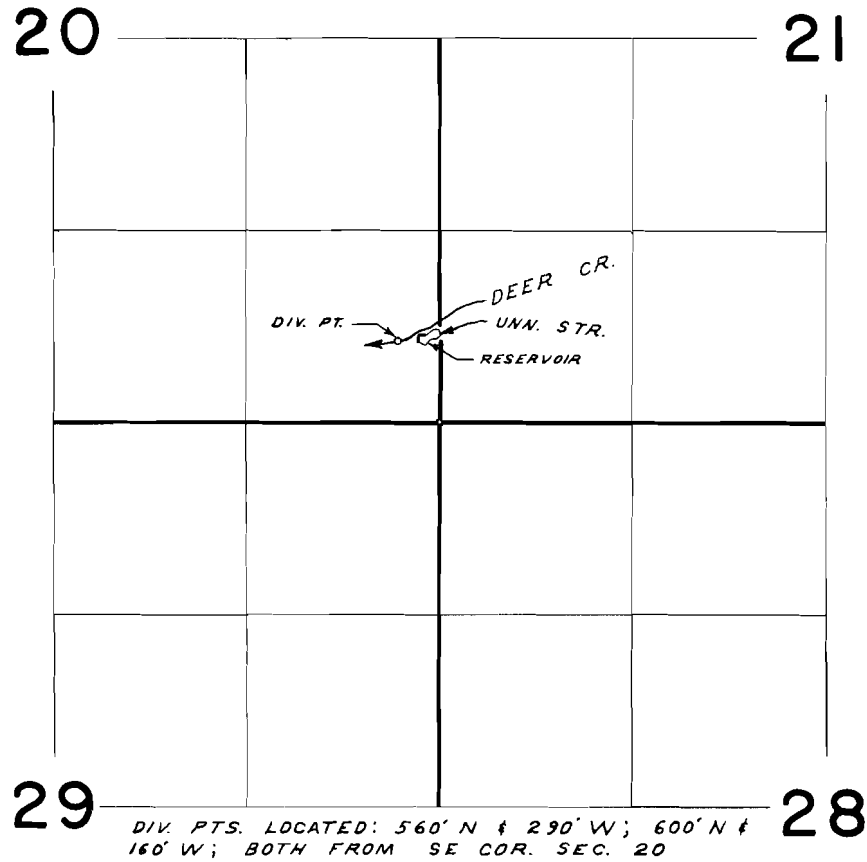

## FINAL PROOF SURVEY UNDER

R-42692 R-4729  
Application No. 42693 Permit No. 31246  
IN NAME OF

C. E. MULLINS

Surveyed OCT. 1 1968, by W. J. RUPPERT