


T.9&10S.R.9W.W.M.

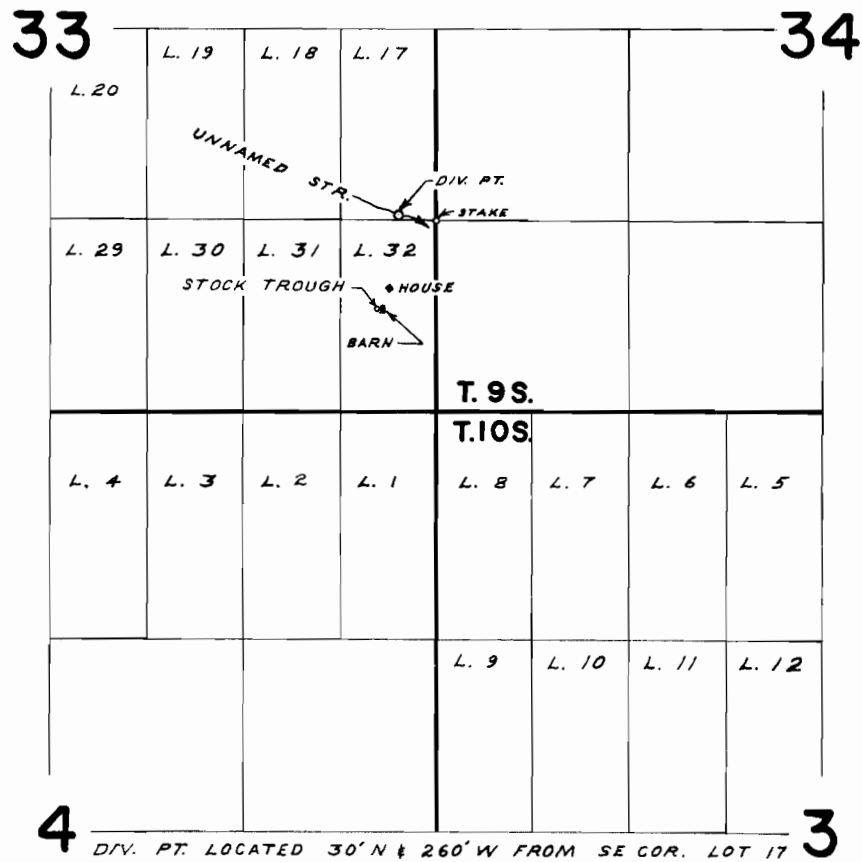

FINAL PROOF SURVEY UNDER

Application No. **43374** Permit No. **32418**
IN NAME OF

IRVIN HOBART

Surveyed **OCT. 3** 1968, by **W. J. RUPPERT**