


T. 13 & 14 S. R. 3 W. W.M.

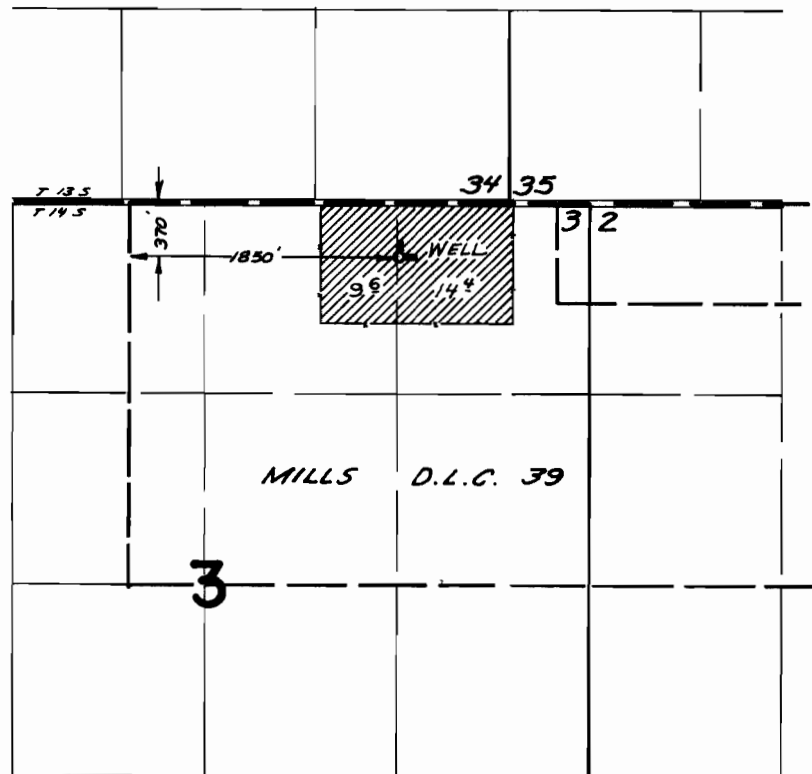

FINAL PROOF SURVEY
UNDER

Application No. G-3622. Permit No. G-3403.
IN NAME OF

EVAN J. SPENCER

Surveyed Nov. 14, 1968, by V. Garner