


T.9 S. R.2W. W.M.

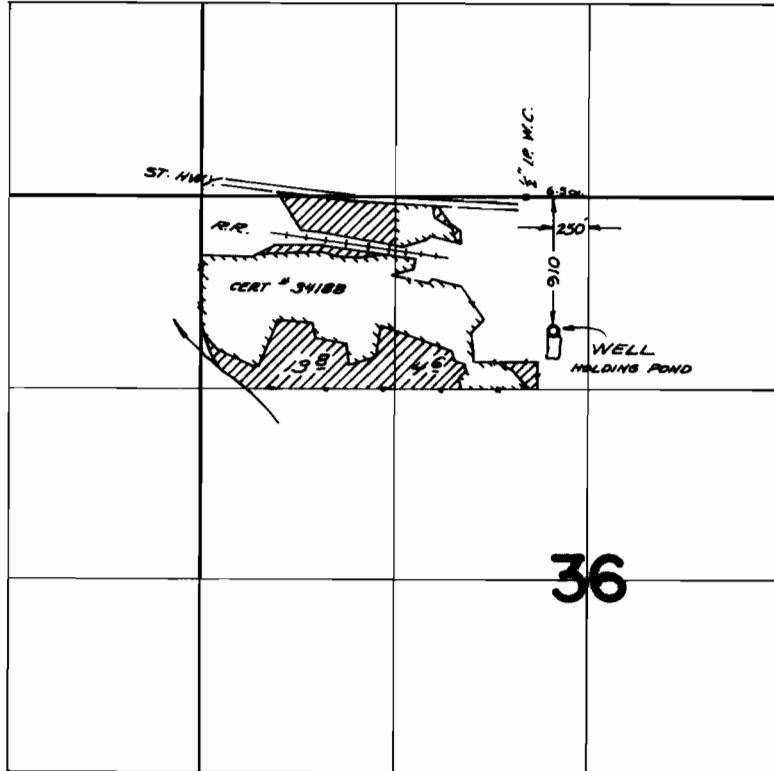

FINAL PROOF SURVEY UNDER

Application No. G-3910 Permit No. G-3694
IN NAME OF

NORTH SANTIAM PLYWOOD CO.

Surveyed Sept 27 1968, by V. Garner