


T.10S. R.2W. W.M.

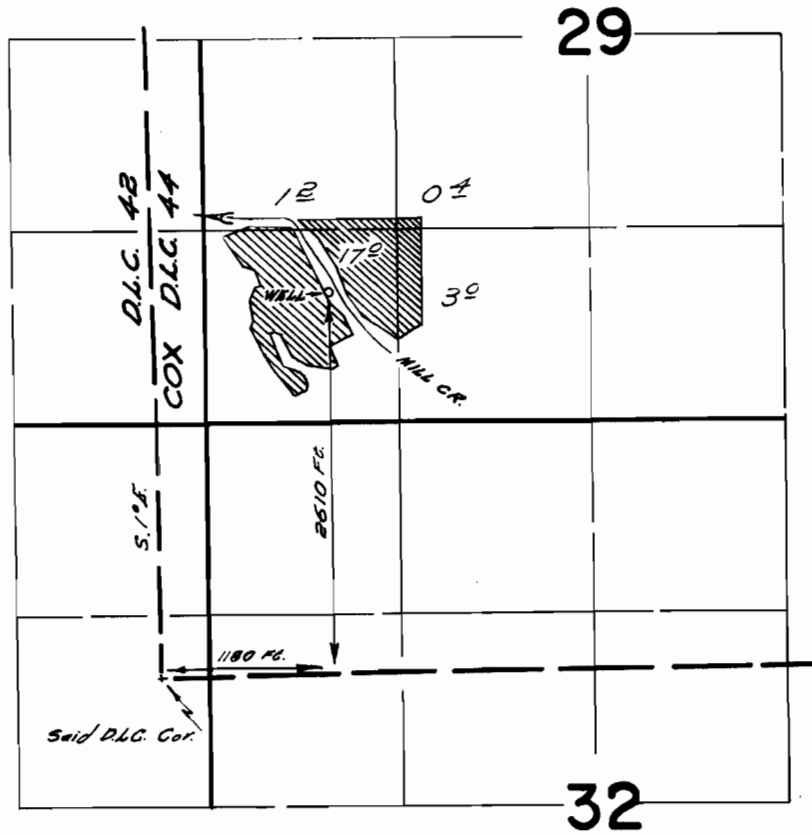

FINAL PROOF SURVEY
UNDER

Application No. *G-3937* Permit No. *G-3695*
IN NAME OF

FRANK W. R. KEE GROVES

Surveyed *March 31 1969*, by *H. J. Appert*