


# T. 10 S. R. 1 W. W. M.

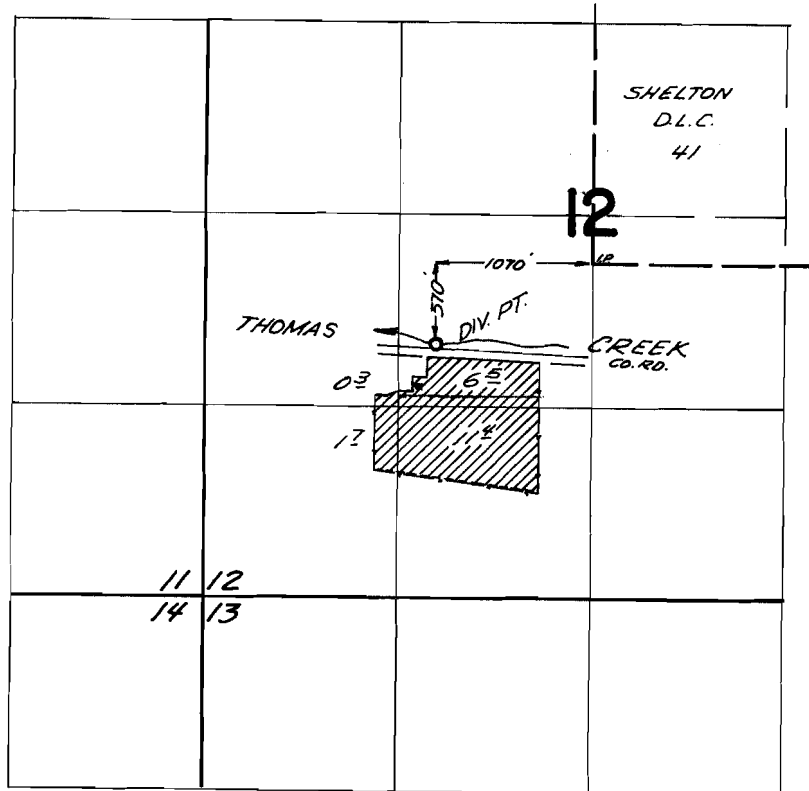

## FINAL PROOF SURVEY UNDER

Application No. 40272... Permit No. 30253...  
IN NAME OF

Mrs. JAMES L. KEENEN

Surveyed Nov. 7, 1968., by V. Garner