


T.9 S. R.2 E. W.M.

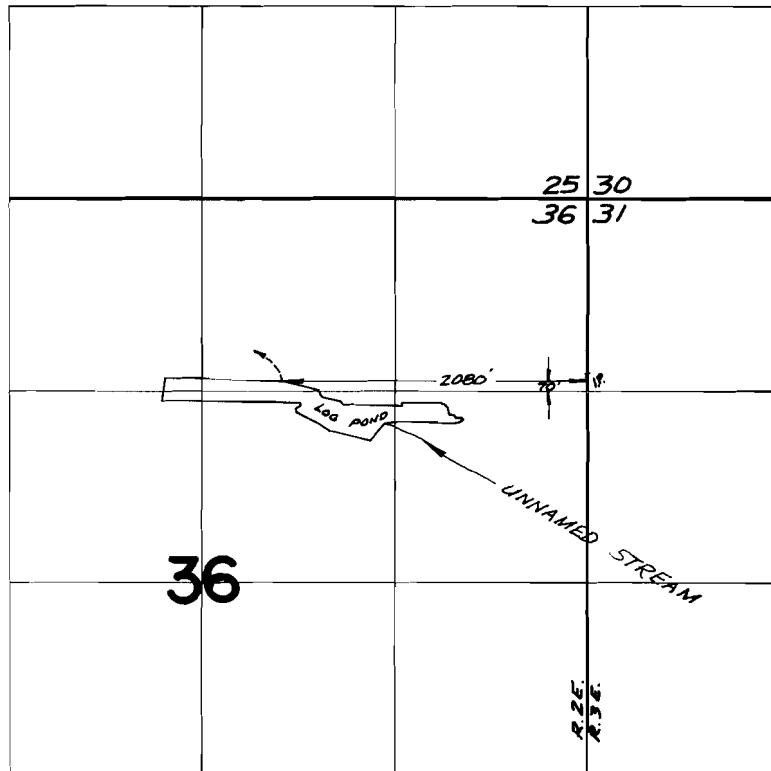

FINAL PROOF SURVEY UNDER

Application No. *R-41045* *41045* Permit No. *R-4631* *30719*
IN NAME OF

FRANK LUMBER CO. INC.

Surveyed *Sept 26 1968*, by *V. Garner*