


# T.9 S. R.2 E. W.M.

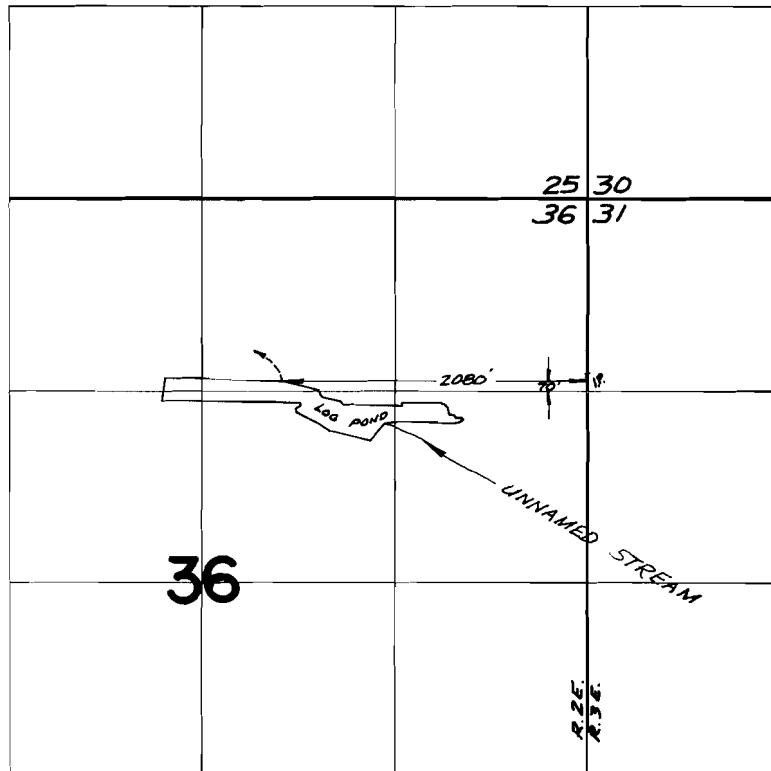

## FINAL PROOF SURVEY UNDER

Application No. R-41045 Permit No. R-4631  
41046 30719  
IN NAME OF

FRANK LUMBER CO. INC.

Surveyed Sept 26 1968, by V. Garner