


T I O S. R I E. W. M.

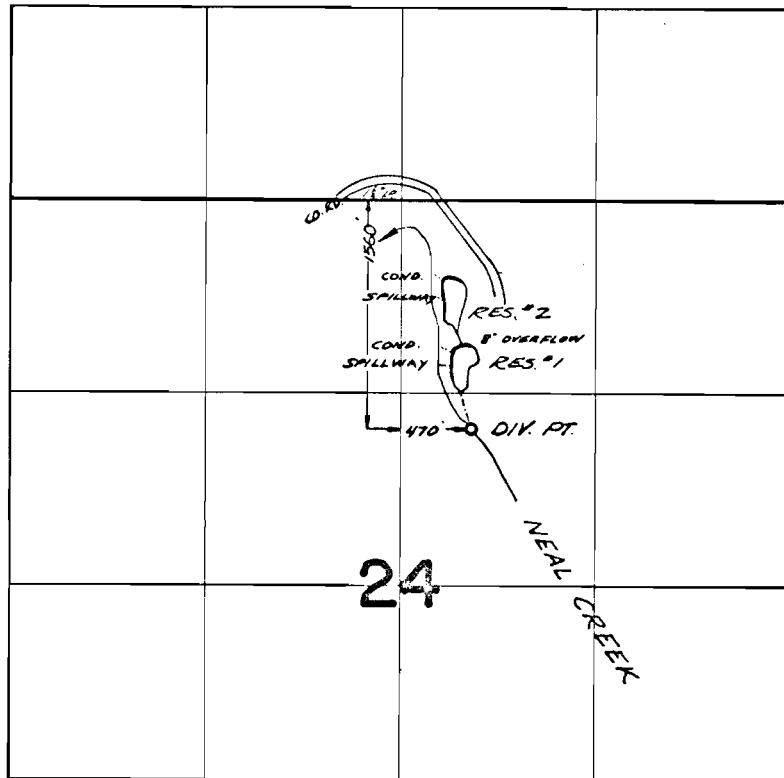

FINAL PROOF SURVEY UNDER

R-42796 R-4765
Application No. 42797 Permit No. 31348
IN NAME OF

W. J. ROBERTS and W. E. DUNHAM.

Surveyed *Sept. 25 1968*, by *V. Garner*.....