


T I O S. R I E. W. M.

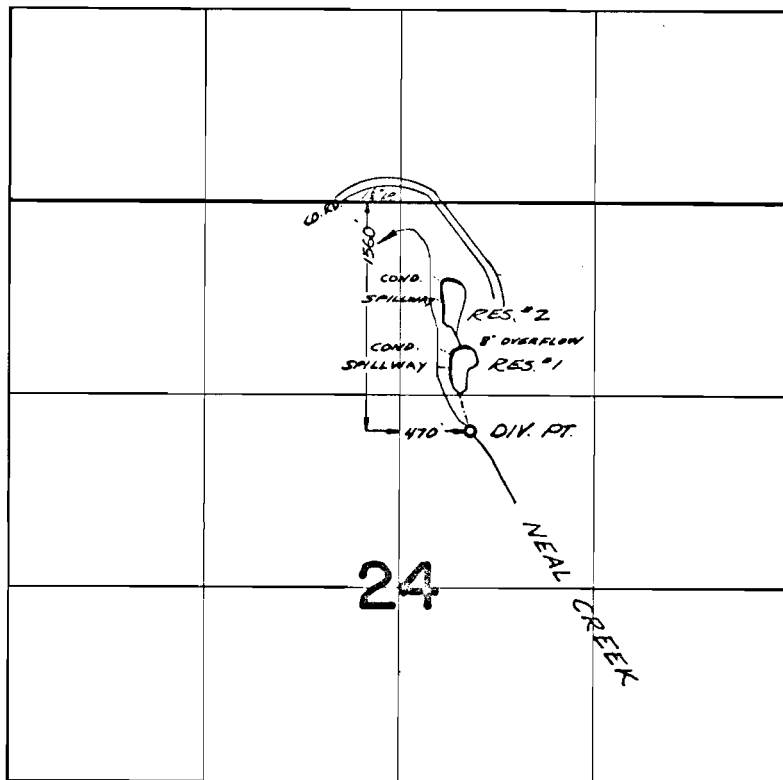

FINAL PROOF SURVEY UNDER

R-42796 *R-4765*
Application No. *42797* Permit No. *31348*
IN NAME OF

W. J. ROBERTS and W. E. DUNHAM.

Surveyed *Sept. 25 1968*, by *V. Garner*.....