


T.9 S. R.3 E. W.M.

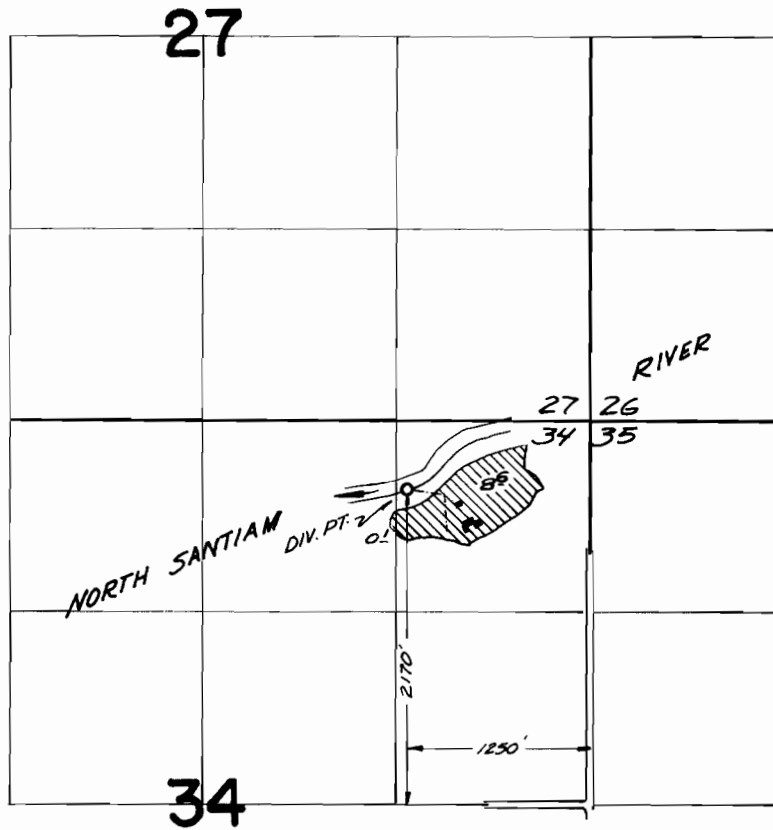

FINAL PROOF SURVEY
UNDER

Application No. 42598 Permit No. 31825
IN NAME OF

BILL GLEASON

Surveyed *SEPT. 24, 1968*, by *V. Garner*