


T. 18 S.R. 47 E.W.M.

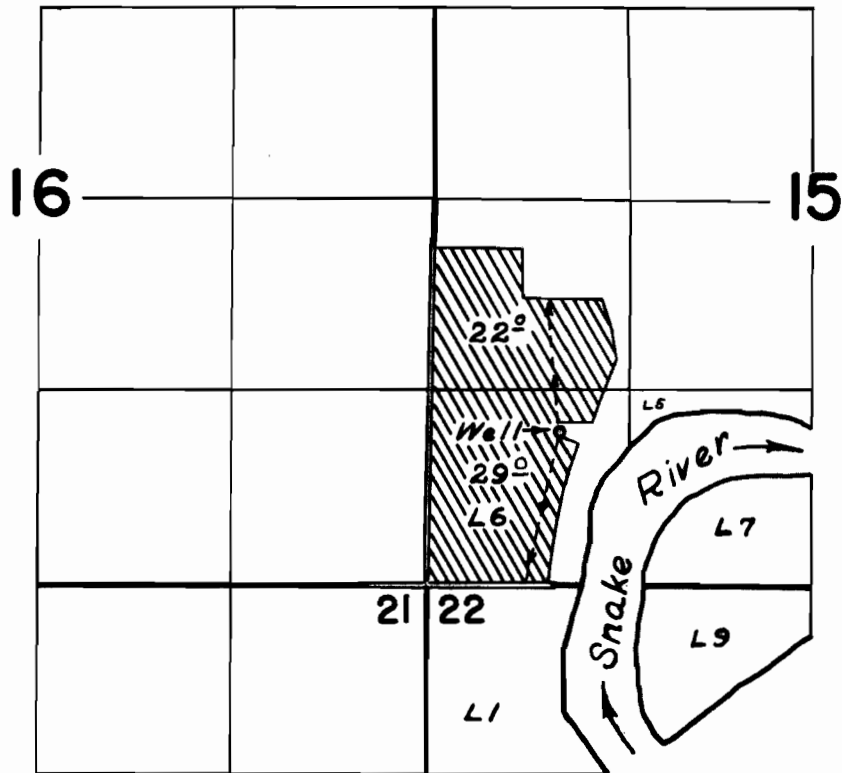

Well located 1050 ft. N. & 890 ft. E. from S.W. corner Section 15

FINAL PROOF SURVEY
UNDER

Application No. *G-1493* Permit No. *G-1418*
IN NAME OF

KATIE HASHITANI

Surveyed *June 11, 1962*, by *C.R. Baker*