


# T.41S. R.43 E.W.M.

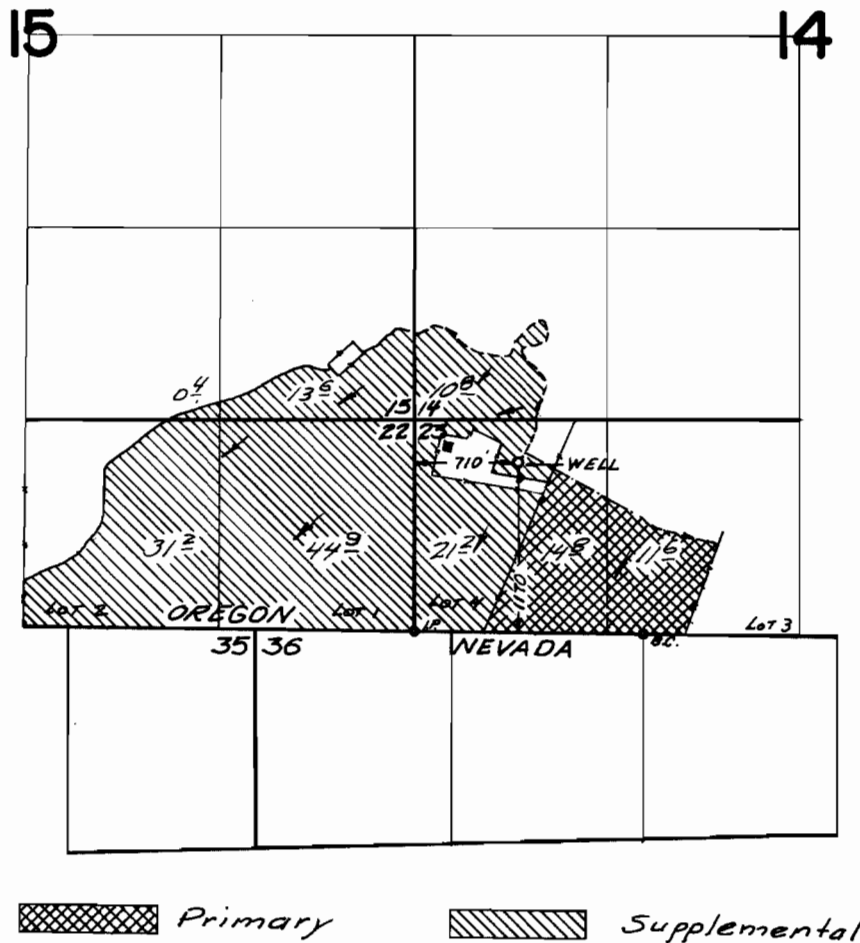

## FINAL PROOF SURVEY UNDER

Application No. G-2619... Permit No. G-2438  
IN NAME OF

*JOHN P. NOUQUE and JEANNE NOUQUE*

Surveyed Oct. 24, 1968, by *V. Garner*