


T.16 S.R. 47 E.W.M.

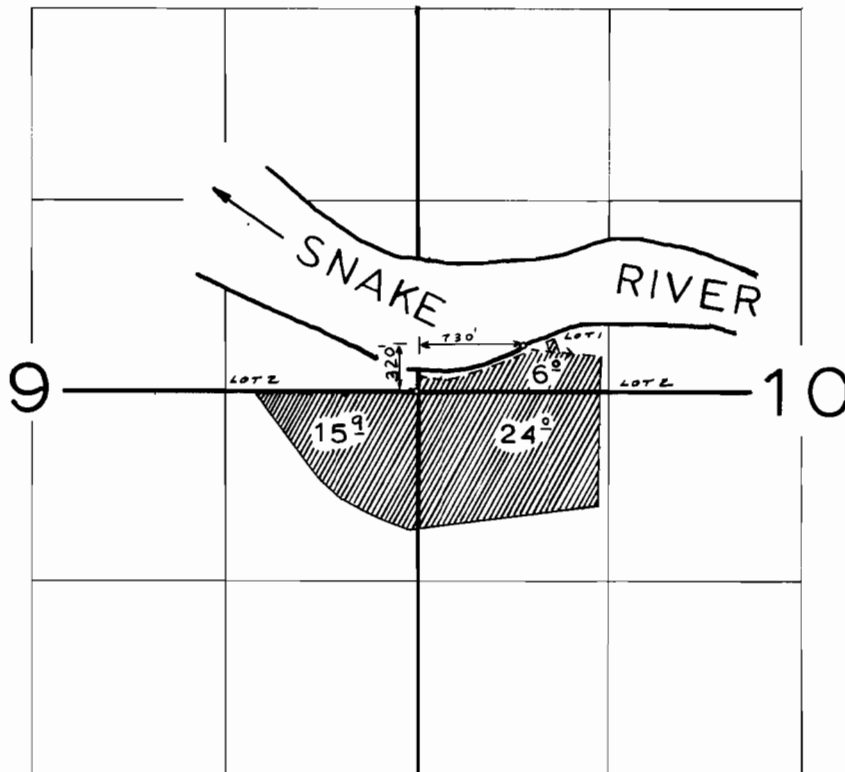

FINAL PROOF SURVEY
UNDER

Application No. 41347... Permit No. 30733...
IN NAME OF

FRANK HILL

Surveyed MARCH 14 1968, by E. E. F. RING...