


T.30 S. R.46 E.W.M.

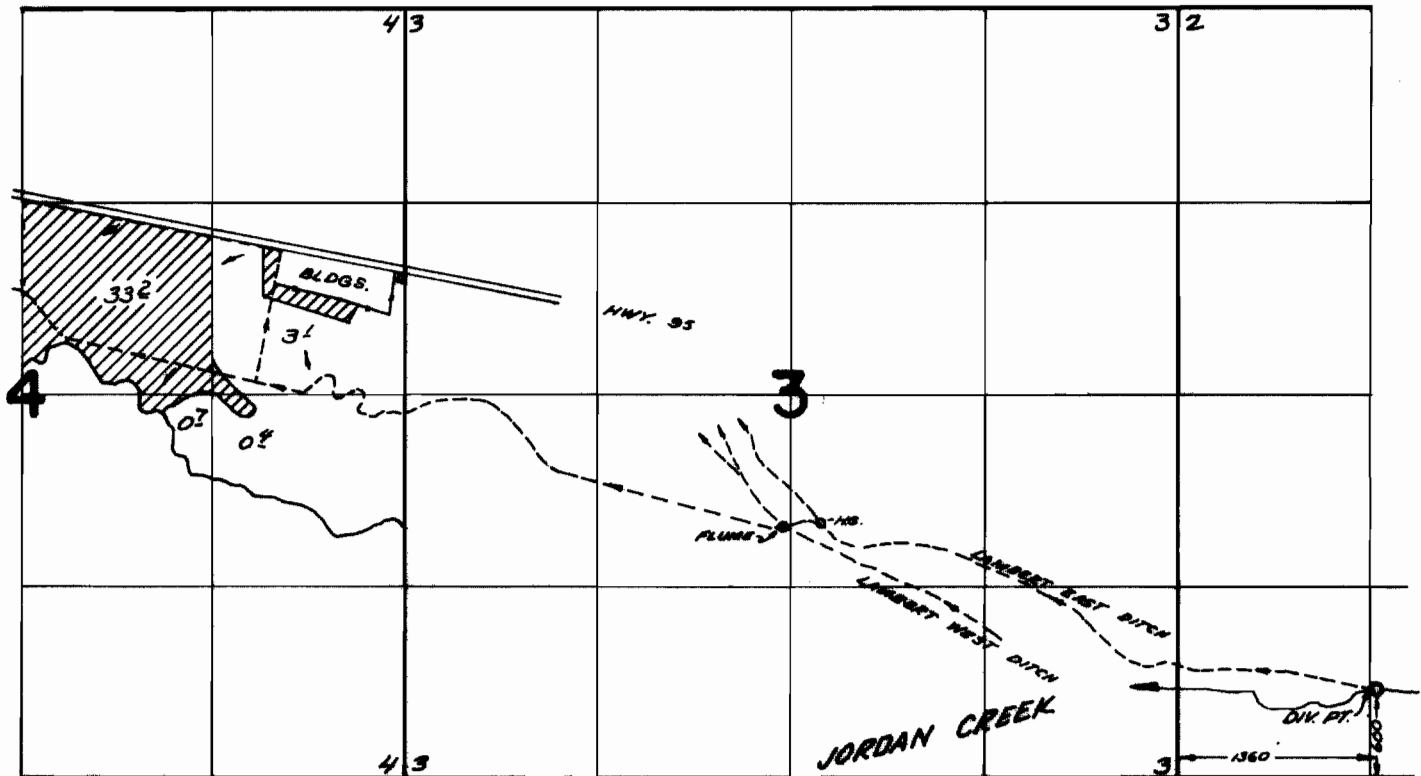

FINAL PROOF SURVEY

UNDER

Application No. 42824 Permit No. 32007
IN NAME OF

FLORENCE and BILL ROSS

Surveyed Oct. 29, 1968, by V. Garner