


# T. 7 S. R. 1 W. W. M.

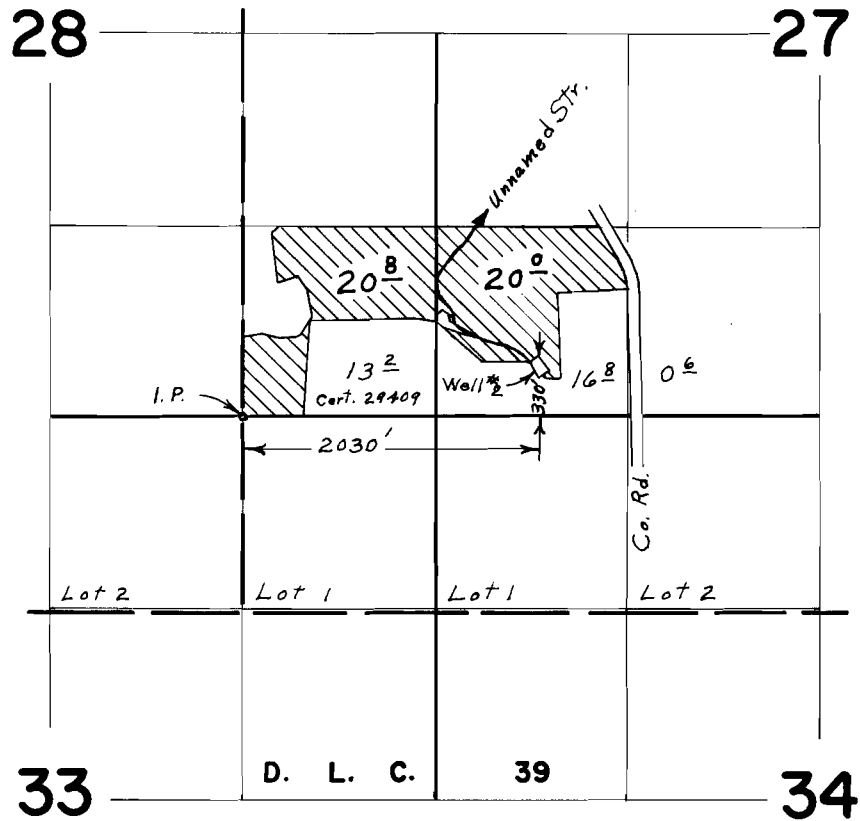

## FINAL PROOF SURVEY UNDER

Application No. ~~G-2833~~ Permit No. ~~G-2634~~  
IN NAME OF

KEITH G. JOHNSON

Surveyed July 3, 1968, by L. E. Gould