


T.5S.R.2W. W.M.

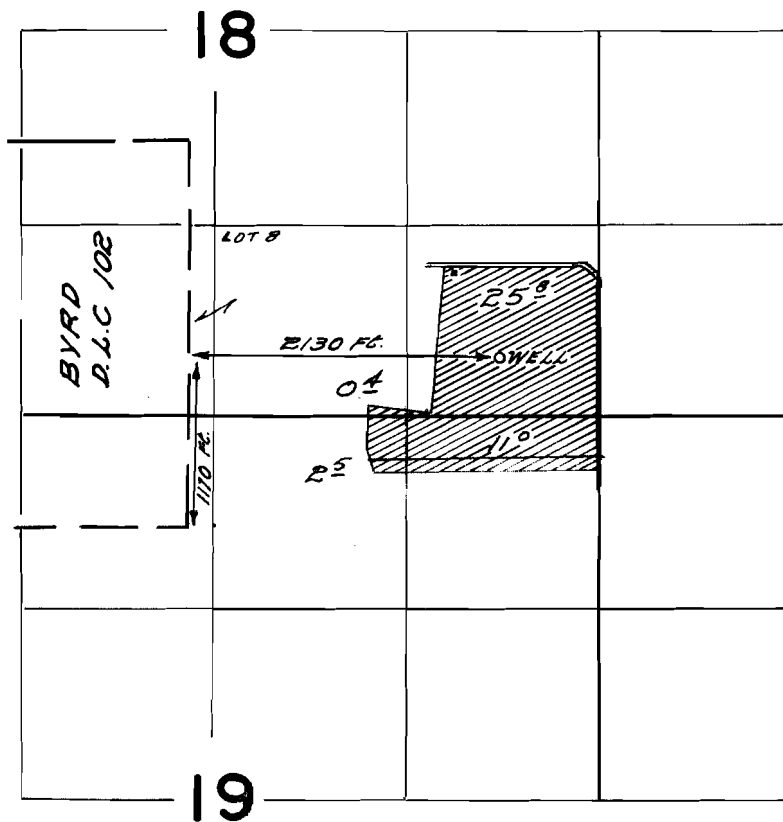

FINAL PROOF SURVEY
UNDER

Application No. *G-3004* Permit No. *G-2799*
IN NAME OF

NORMAN NIBLER

Surveyed *April 17 1968*, by *D.R. Buell*