


T. 10 S. R. 3 W. W. M.

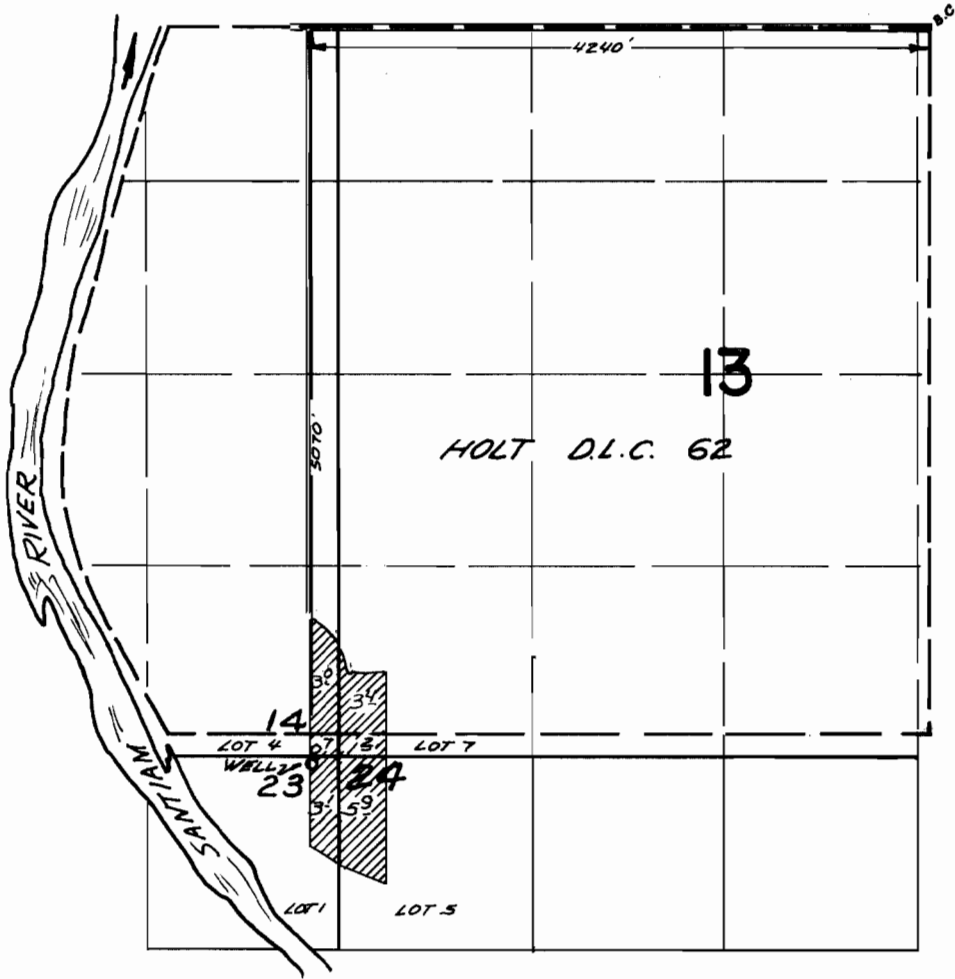

FINAL PROOF SURVEY
UNDER

Application No. *G:3635* Permit No. *G:3249*
IN NAME OF

ERNEST H. AERNI

Surveyed *July 26 1968*, by *V. Garner*