


T. 5S. R. 2W. W.M.

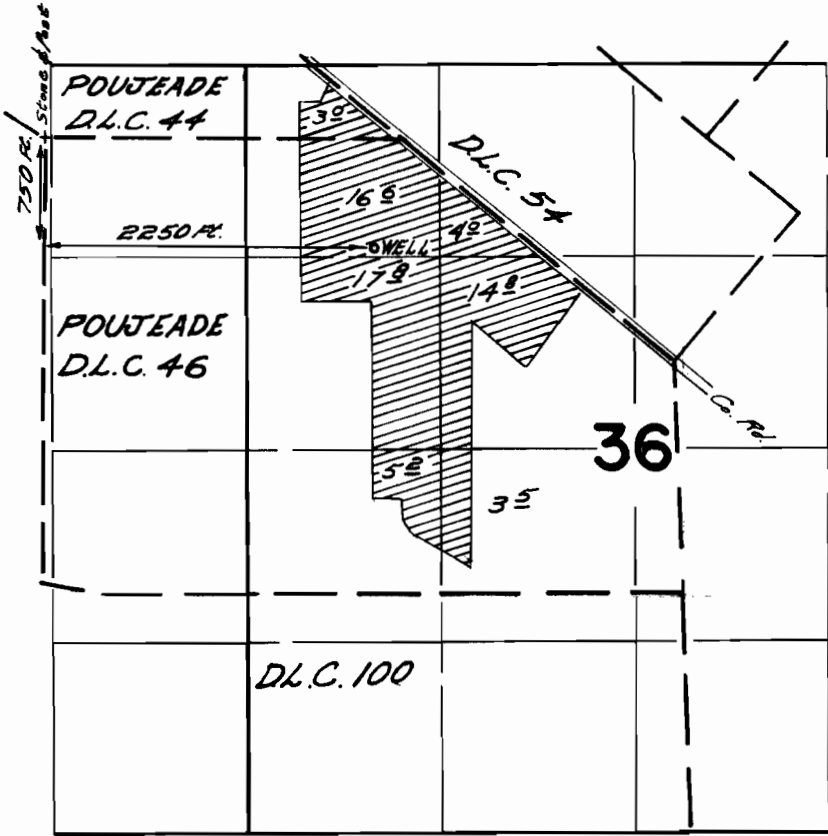

FINAL PROOF SURVEY
UNDER

Application No. G-3879. Permit No. G-3647
IN NAME OF

JAMES RICHARD MOULLET

Surveyed April 9, 1968, by *Wd. Ruppert*