


T.5S.R.2W.W.M.

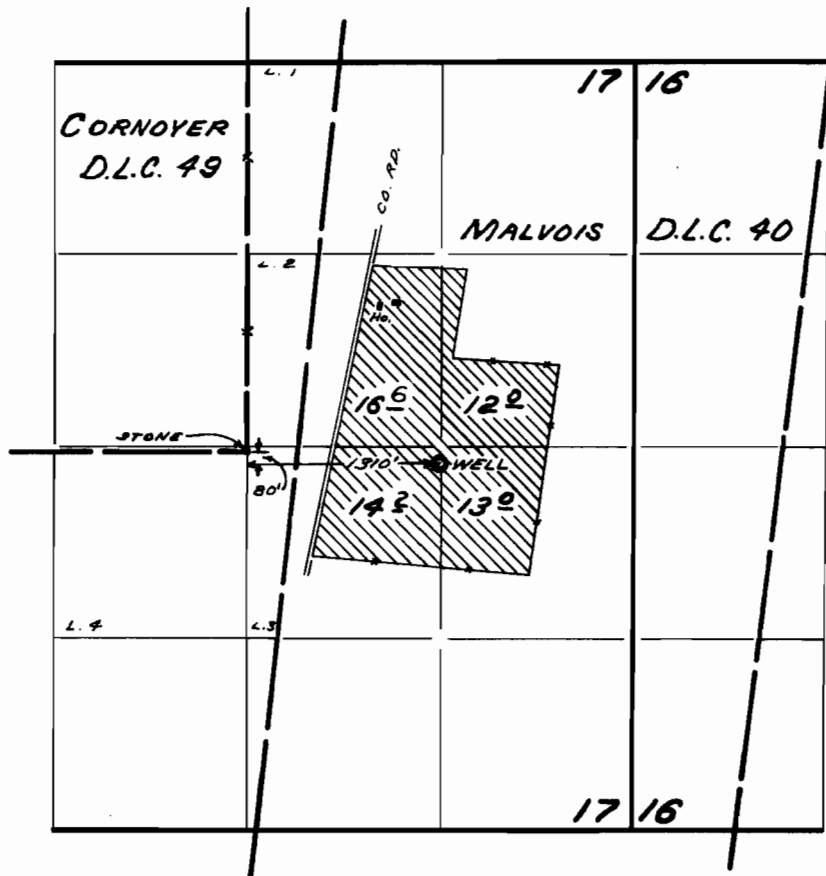

FINAL PROOF SURVEY UNDER

Application No. G-3923 Permit No. G-3684
IN NAME OF

CARL RICHARD NIBLER

Surveyed MAY 9 1968, by W. J. RUPPERT