


T.6S.R.2&3 W.W.M.

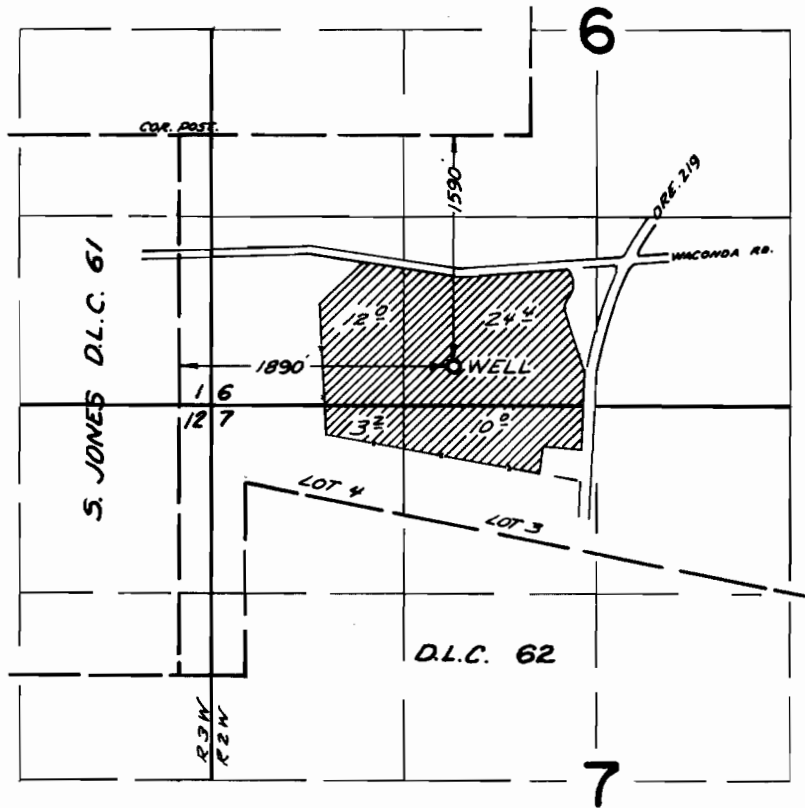

FINAL PROOF SURVEY UNDER

Application No. *G-4038*. Permit No. *G-3786*.
IN NAME OF

ODIN A and ELLEN J. HOLLIN

Surveyed *Aug 13, 1968*, by *V. Garner*