T. 8 S. R. 2 W. W. M.

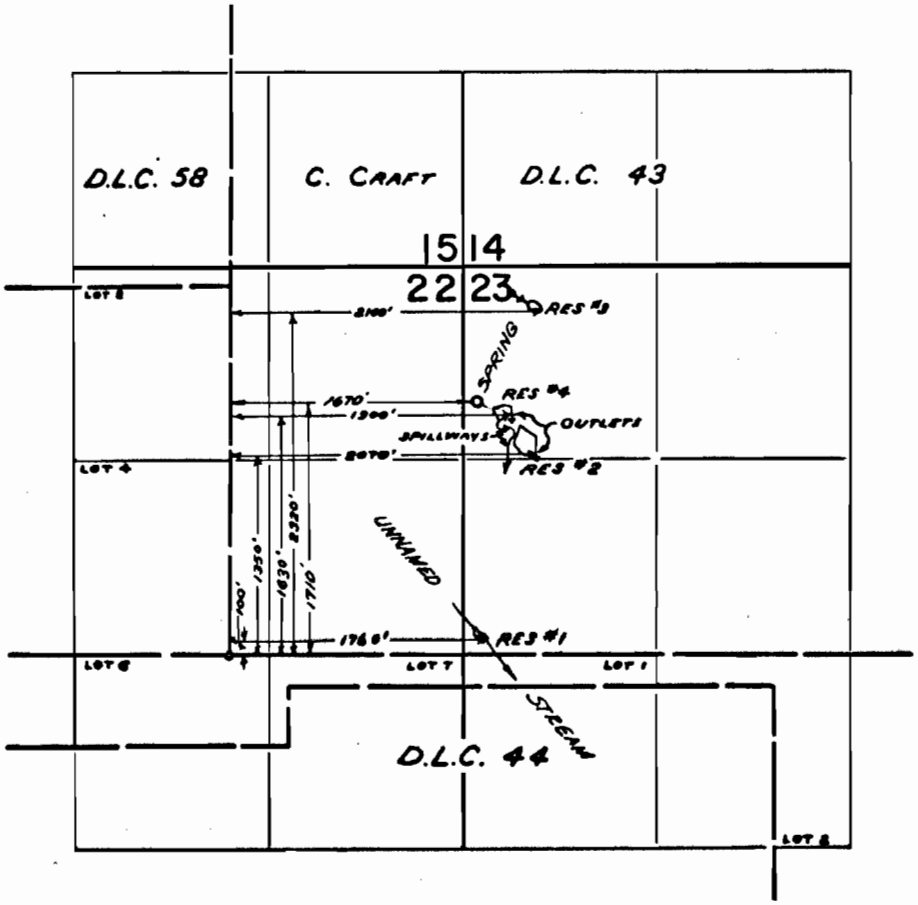

FINAL PROOF SURVEY
UNDER

Application No. R-33028 33029 Permit No. R-2248 26217

IN NAME OF

Clyde L. Thommen

Surveyed JUL. 7 1965, by C. GARDNER
Insp. May 9 1968 V. Garner

1965-N ORA