


T. 6 S. R. 1 E. W. M.

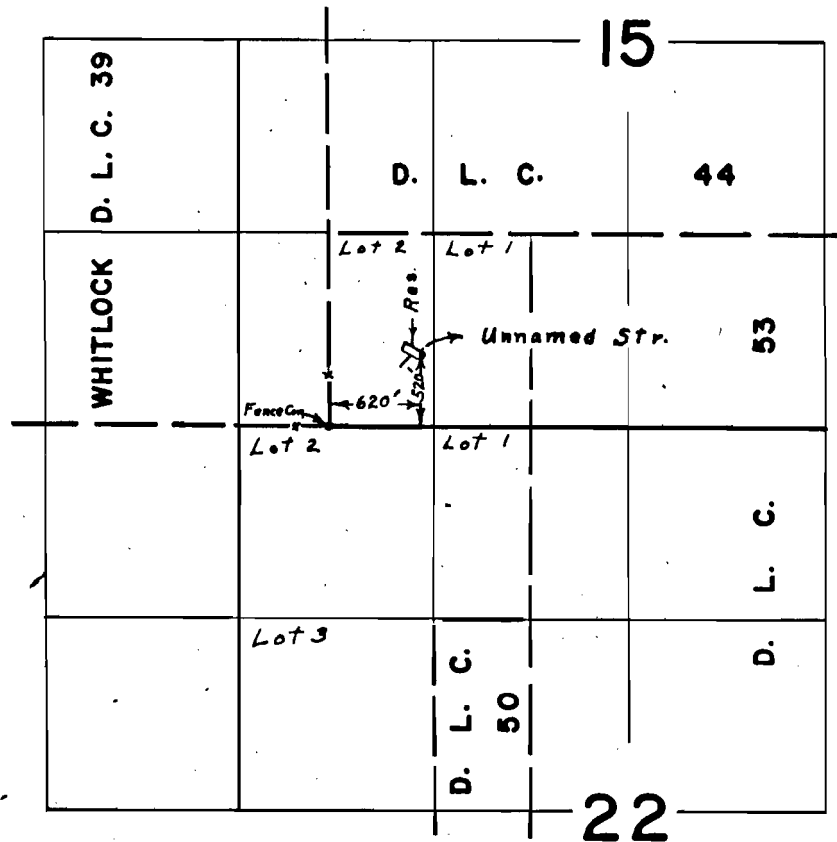

FINAL PROOF SURVEY UNDER

R-38795 R-3267
Application No. 38796 Permit No. 28856
IN NAME OF

J. G. KAVANAUGH Lloyd R. Verrier

Surveyed May 22 1968, by L. E. Gould