


# T. 6 S. R. 1 E. W. M.

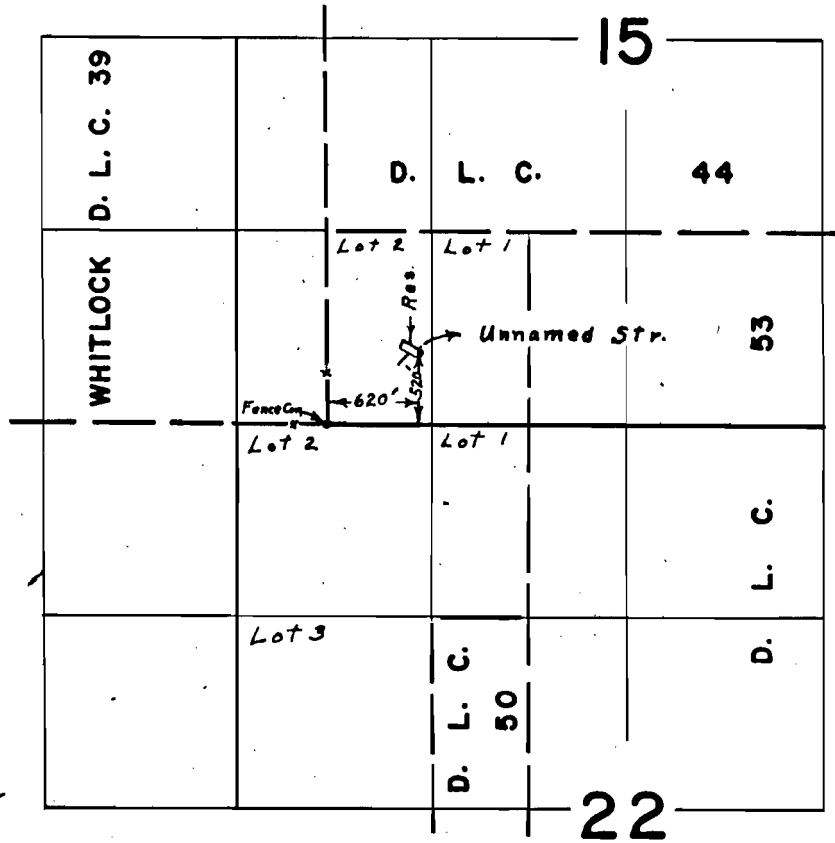

## FINAL PROOF SURVEY UNDER

R-38795 R-3267  
Application No. 38796 Permit No. 28856  
IN NAME OF

J. G. KAVANAUGH Lloyd R. Verrier

Surveyed May 29 1968, by L. E. Gould