


T.5S. R.1W.&E. W.M.

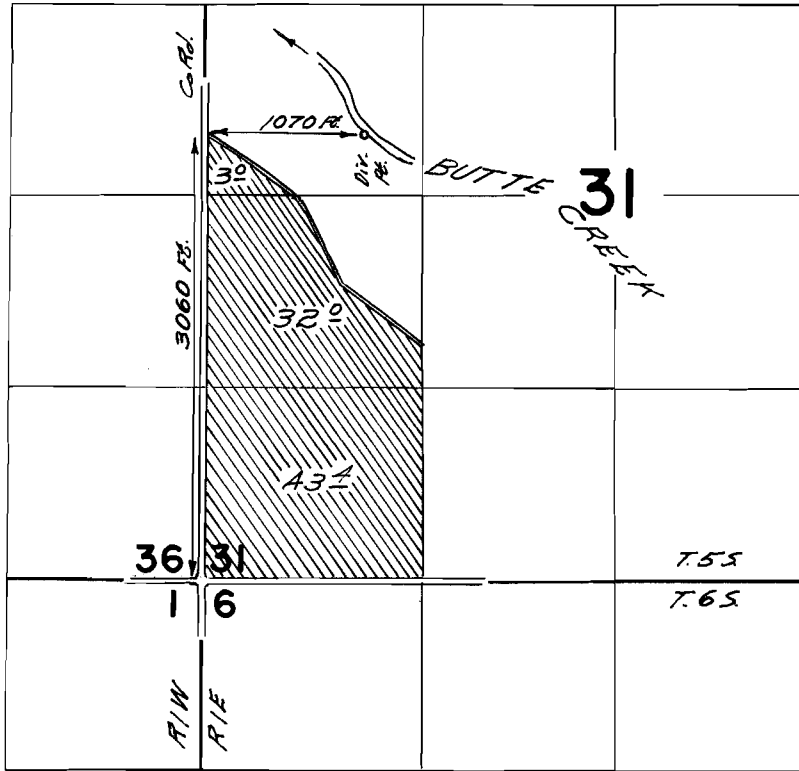

FINAL PROOF SURVEY UNDER

Application No. 40569. Permit No. 30229
IN NAME OF

CLARENCE MEDACK

Surveyed June 19 1968, by *W.D. Ruppert*