


T.5S. R.1W. W.M.

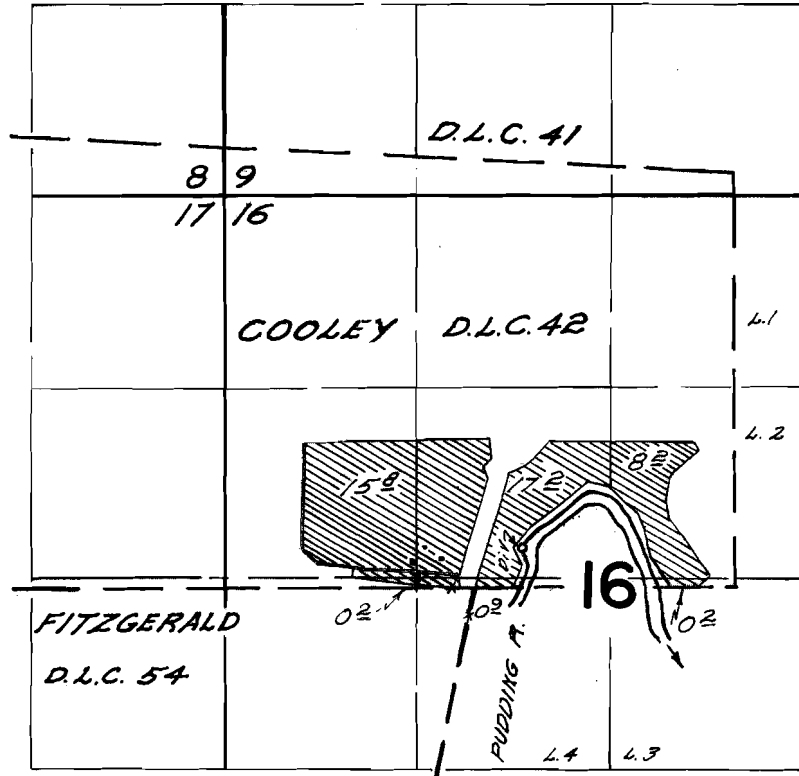

DIVERSION POINT LOCATED 270 FE. N. & 320 FE. E. FROM N.E. CORNER D.L.C. 54

FINAL PROOF SURVEY UNDER

Application No. 40733... Permit No. 30339
IN NAME OF

ROBERT J. DRYDEN

Surveyed April 15 1968, by *W. d. Ruppert*