


T.4S.R.1W.W.M.

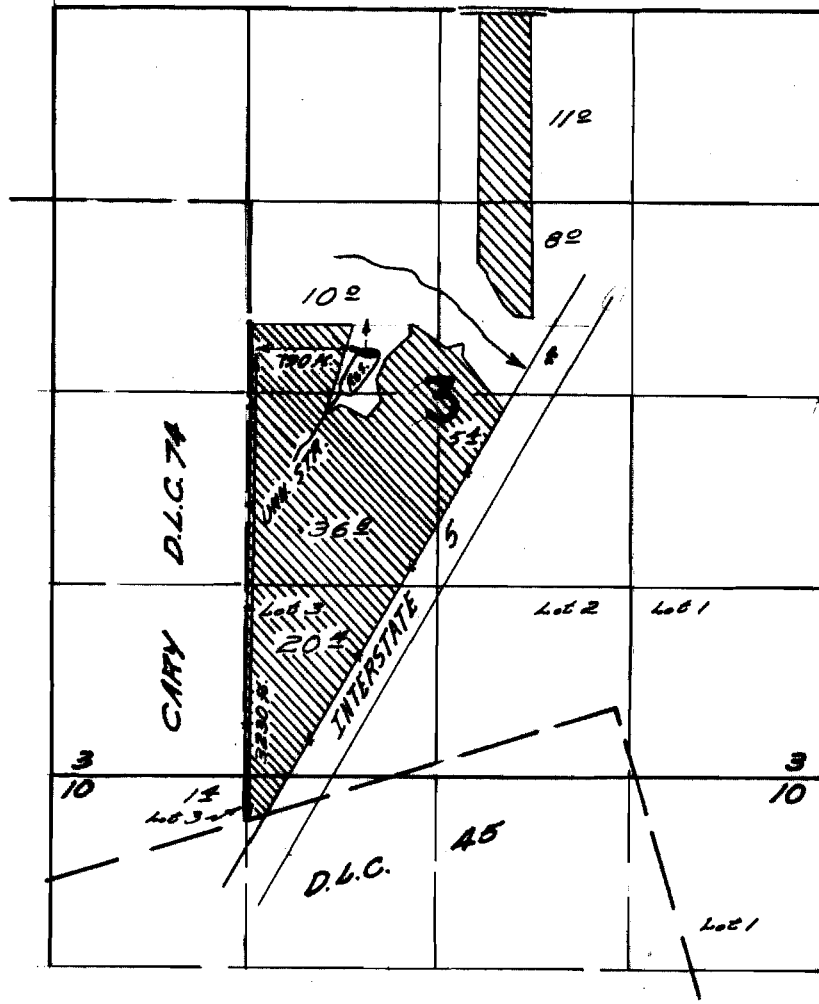

FINAL PROOF SURVEY
UNDER

R-40374 R-4581
Application No. ~~40375~~ Permit No. ~~30445~~
IN NAME OF

DONALD L. NUFFER

Surveyed May 9, 1968, by W. d. Ruggert