T. 4 S. R. 1 W. W.M.

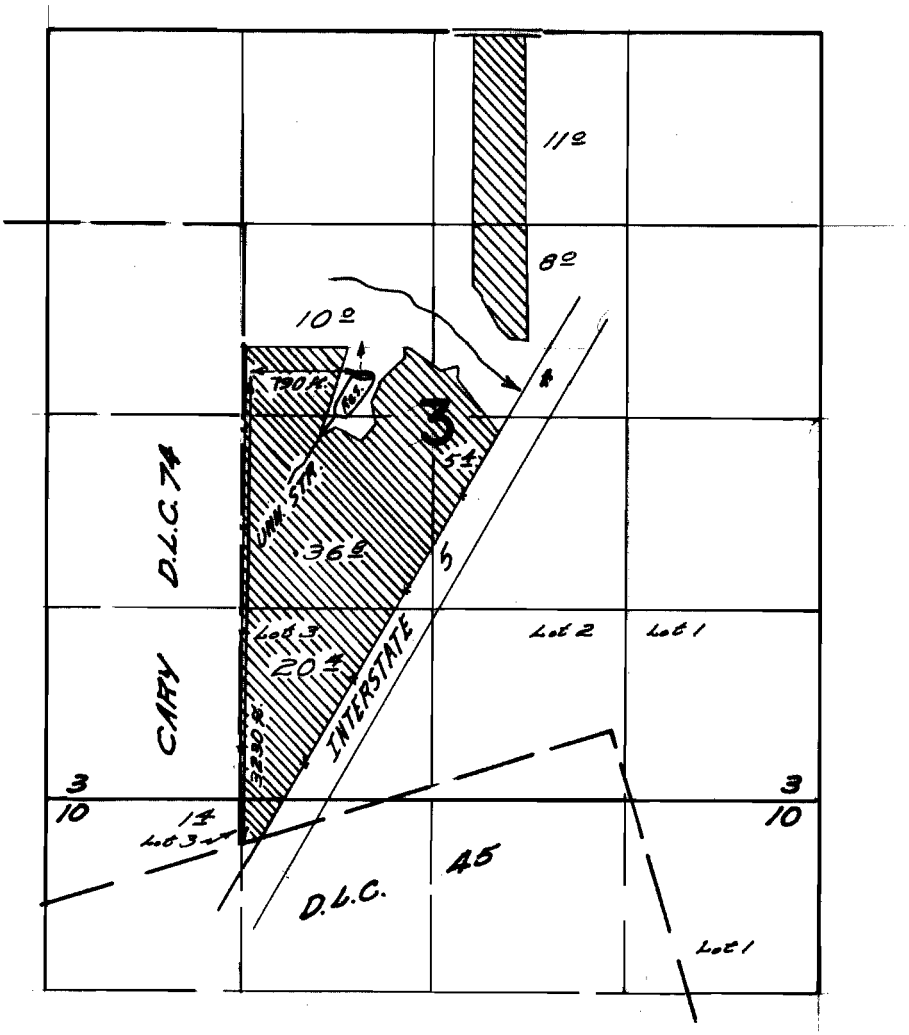

FINAL PROOF SURVEY
UNDER

Application No. ~~40375~~ R-40374 Permit No. ~~30446~~ R-4581
IN NAME OF

DONALD L. NUFFER

Surveyed May 9 1968, by W. d. Huggart

1968 - J.