

Found 1/2" I.P.
Found 3/4" I.P.

Found 1/2" I.P.

Meas. 315.6'
Set Nail at Intersection
of Record Distances

Record Brq. N89°40'E Meas. Dist. 969.65

Approx. center of NW 1/4
Sec 21, T85.14W.

76 Ac


Water Line

Well #1

Stud. Mill


Total = 15 ± AC

76 AC.

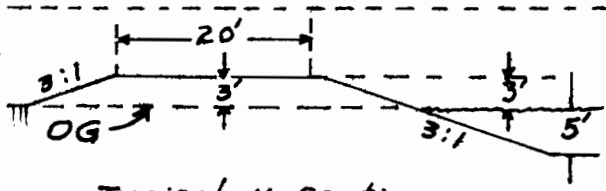

Typical X-section
Dike at North End
of Pond

Scale: 1" = 10'

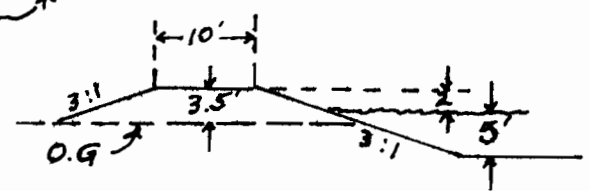

Typical X-section
Dike at South End
of Pond

County Road No 845

#3 well
18" DIAM
40'-630' south
& 2546' EAST from
N.W. COR. CL-63

Well #2

Inply Mill

Application No. 6-3087

Permit No. 6-2884

RECEIVED

MAY 10 1965

STATE ENGINEER
SALEM OREGON

POLK COUNTY, OREGON
Sections 20 & 21 T85.14W.1W.
Scale 1" = 200'