


# T.8S. R.5W. W.M.

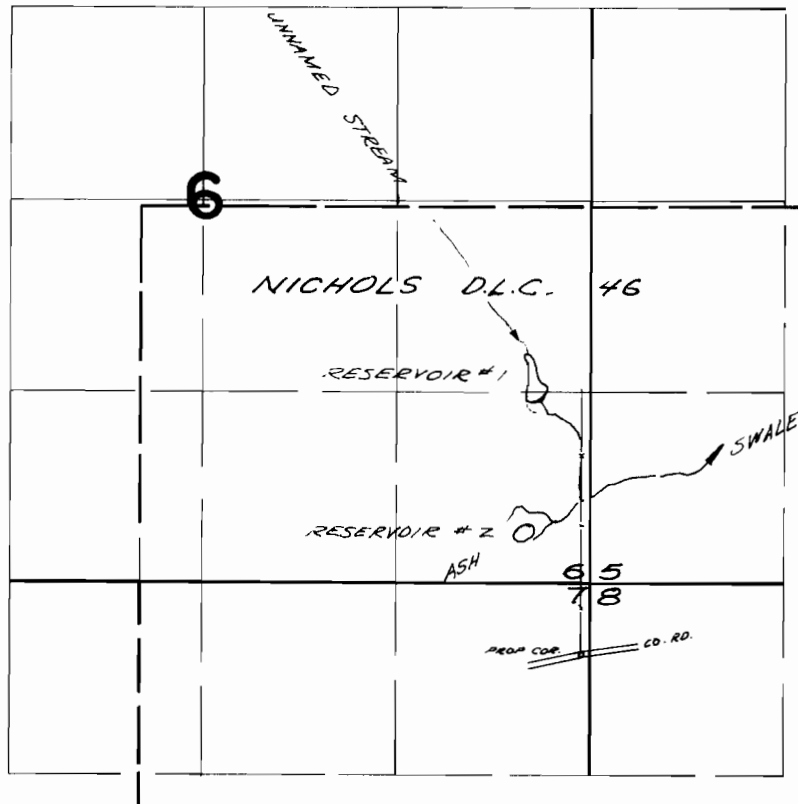

## FINAL PROOF SURVEY UNDER

Application No. *R-44012* Permit No. *R-5073*  
IN NAME OF

*A. F. TROM* .....

Surveyed *Sept 24 1968*, by *W. J. Ruppert*