


T.8&9S. R.5&6W. W.M.

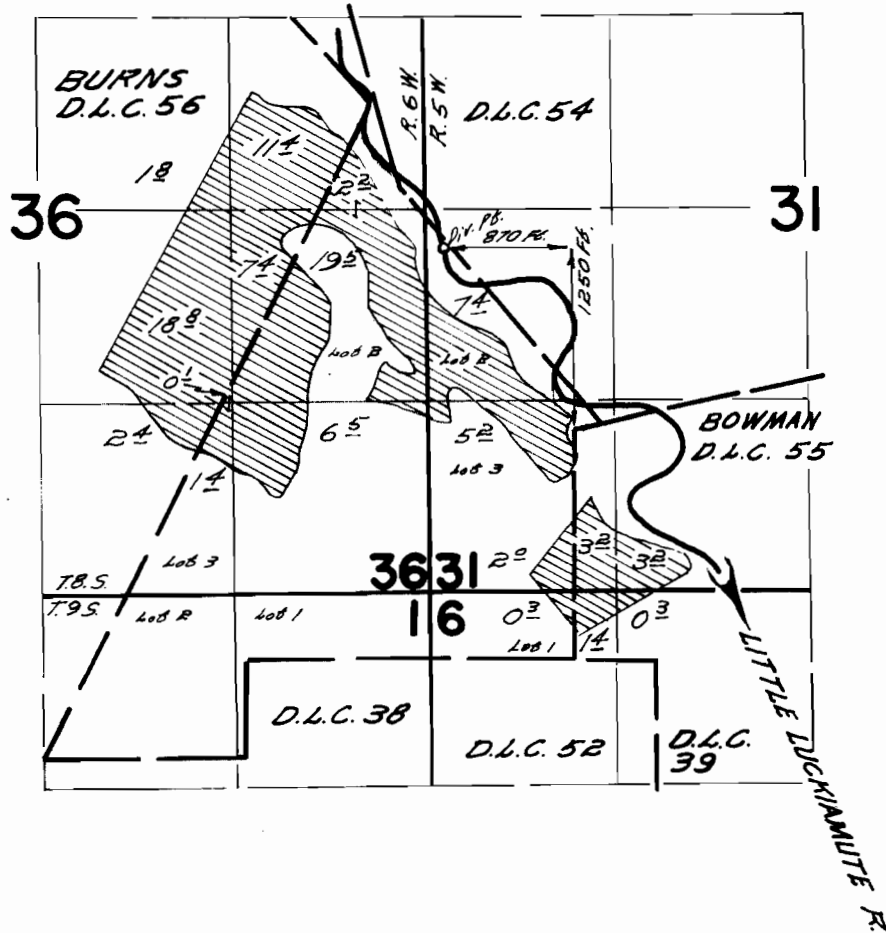

**FINAL PROOF SURVEY**  
UNDER

Application No. 37579. Permit No. 27996.  
IN NAME OF

*DR. C. J. MOSER*

Surveyed Sept. 6, 1968, by *W. J. Ripper*