


T. 7 S. R. 3 & 4 W. W. M..

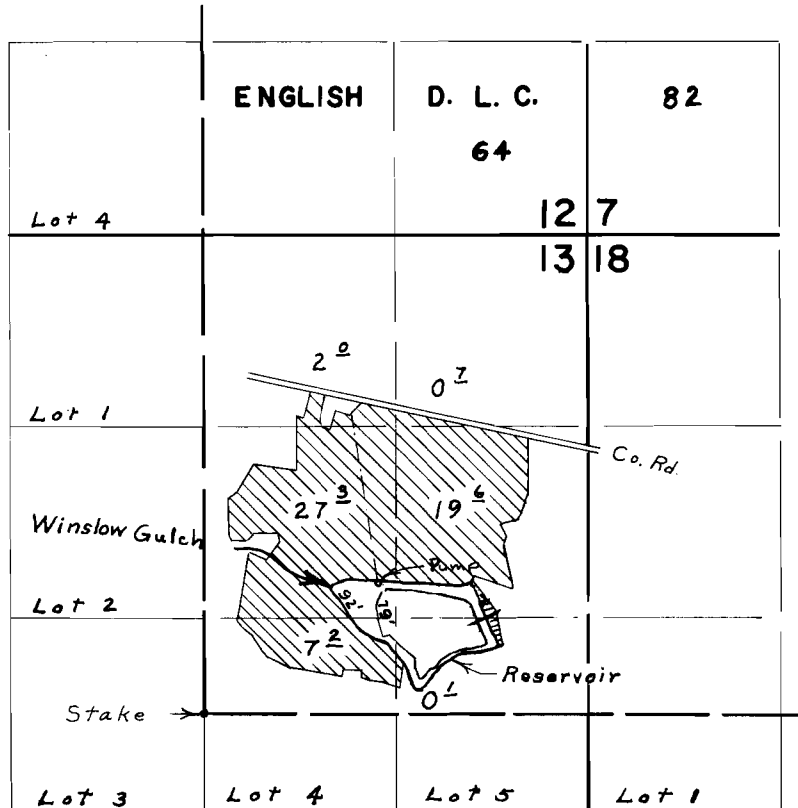

Div. Pt. located 660' N. & 1920' E. from S.W. cor. English D.L.C. 64

FINAL PROOF SURVEY UNDER

R-35109 R-3968
Application No. 35110 Permit No. 29599
IN NAME OF

EDWARD J. CROFT

Surveyed Oct. 17, 1968, by W. J. Ruppert.