


T.8S. R.6W. W.M.

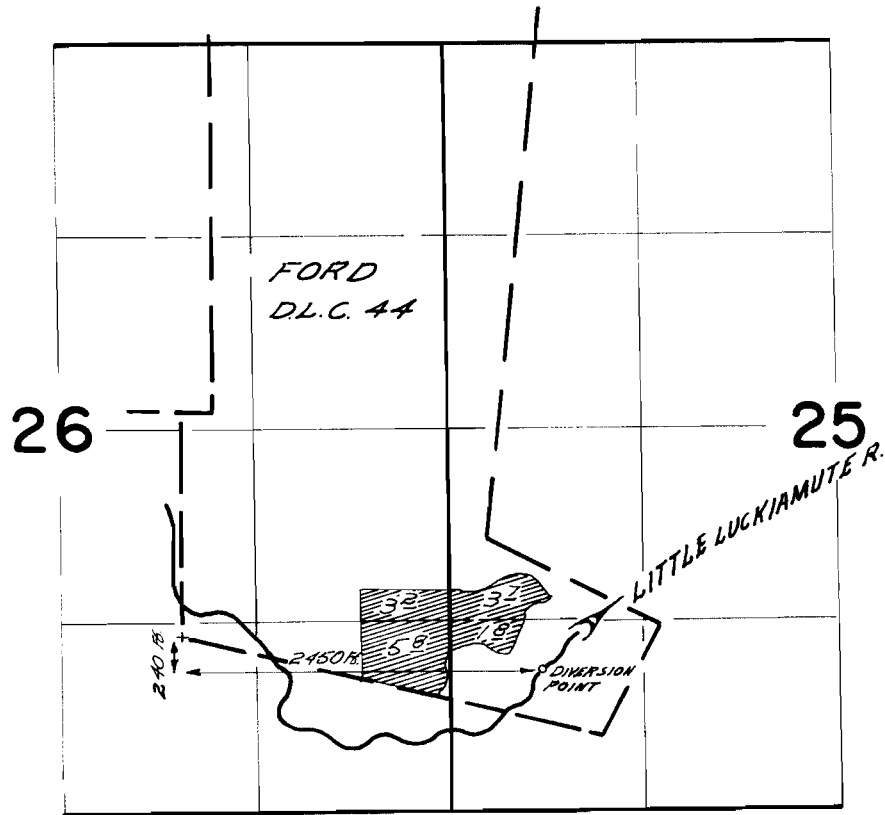

FINAL PROOF SURVEY
UNDER

Application No. 42079 Permit No. 33139
IN NAME OF

MEDA FOSTER

Surveyed *Sept. 5, 1968*, by *W.D. Ruppert*