


T. 7 S. R. 4 W. W.M.

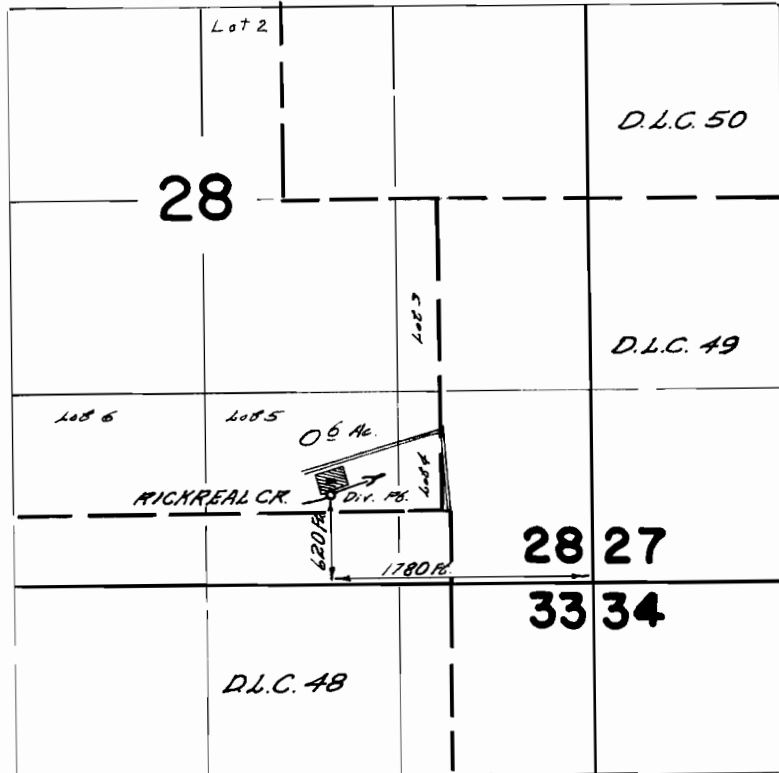

**FINAL PROOF SURVEY**  
UNDER

Application No. 43164 Permit No. 32267  
IN NAME OF

BEN HARRIS SAVAGE

Surveyed July 5, 1968, by W. S. Fupperts