


T. 1 N. R. 2 W. W.M.

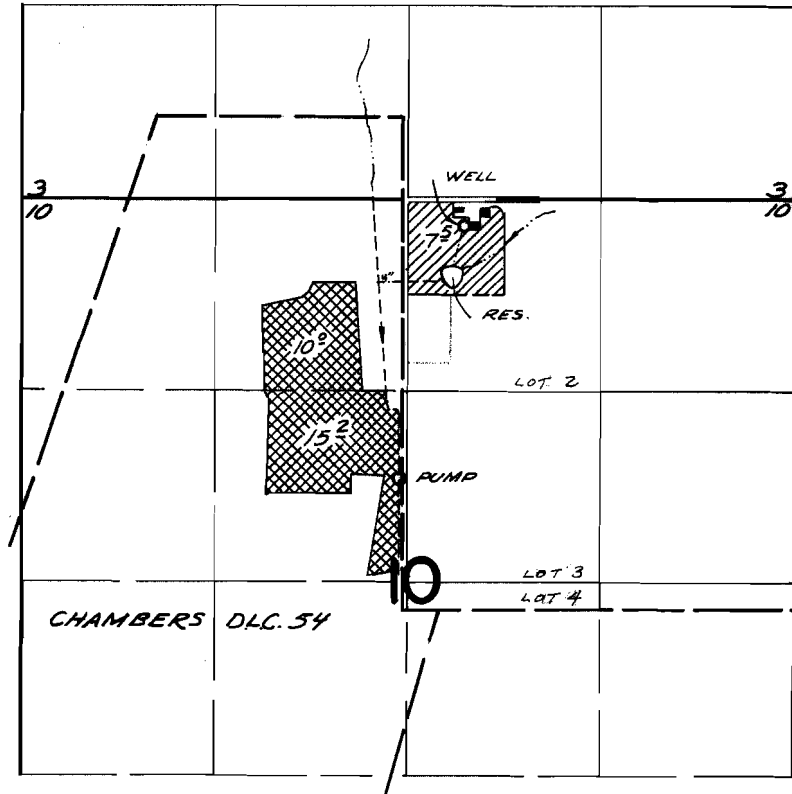

DIV. PTS. LOCATED :- WELL 180 FT. S. & 380 FT. E.; RES. 560 FT. S. & 250 FT. E. BOTH FROM THE N¹/₄ CORNER OF SECTION 10

FINAL PROOF SURVEY UNDER

40193 29984
Application No. G-2955 Permit No. G-2749
IN NAME OF

ELMER J. GROSSEN

Surveyed June 25 1968, by V. Garner