


# T. 2 S. R. 1 W. W.M.

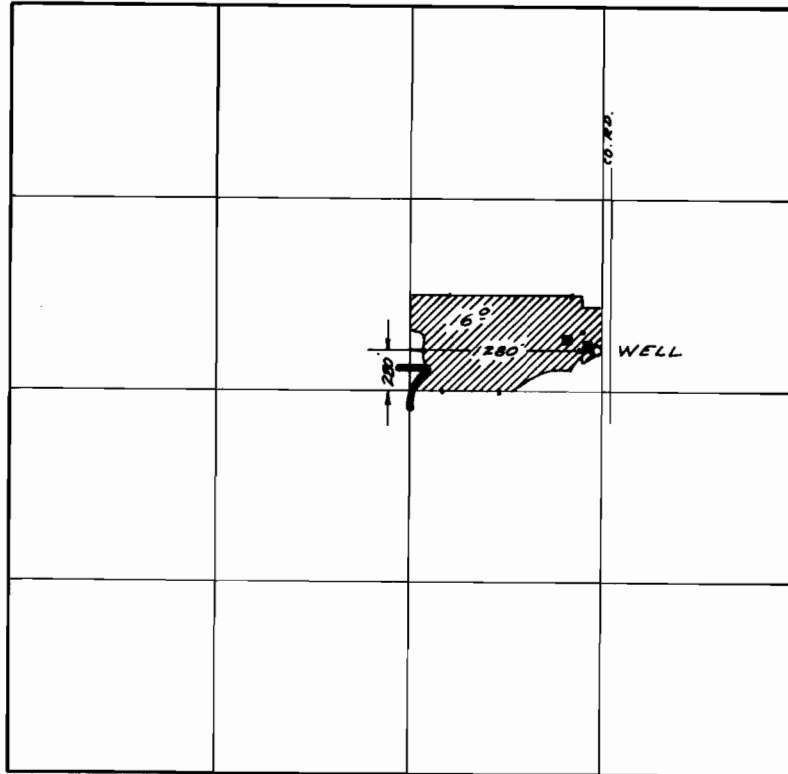

## FINAL PROOF SURVEY UNDER

Application No. G-3752. Permit No. G-3542.  
IN NAME OF

*FRED A. and MARILYN M. MATTHIAS.*

Surveyed *June 28 1968*, by *V. Garner*.