


T.I.S.R.2 W.W.M.

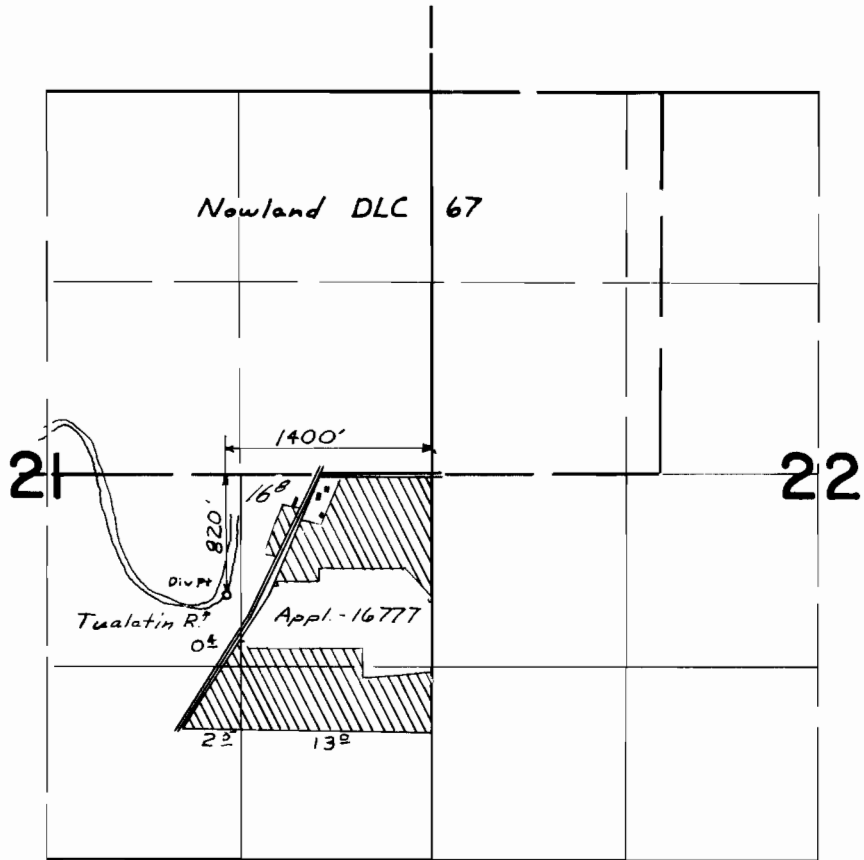

FINAL PROOF SURVEY UNDER

Application No. 39025 Permit No. 29070
IN NAME OF

Fred L. Thurnheer

Surveyed Aug 15, 1967, by *W.J. Ruppert*
Oct 9, 1968