


T. 1 S. R. 4 W. W.M.

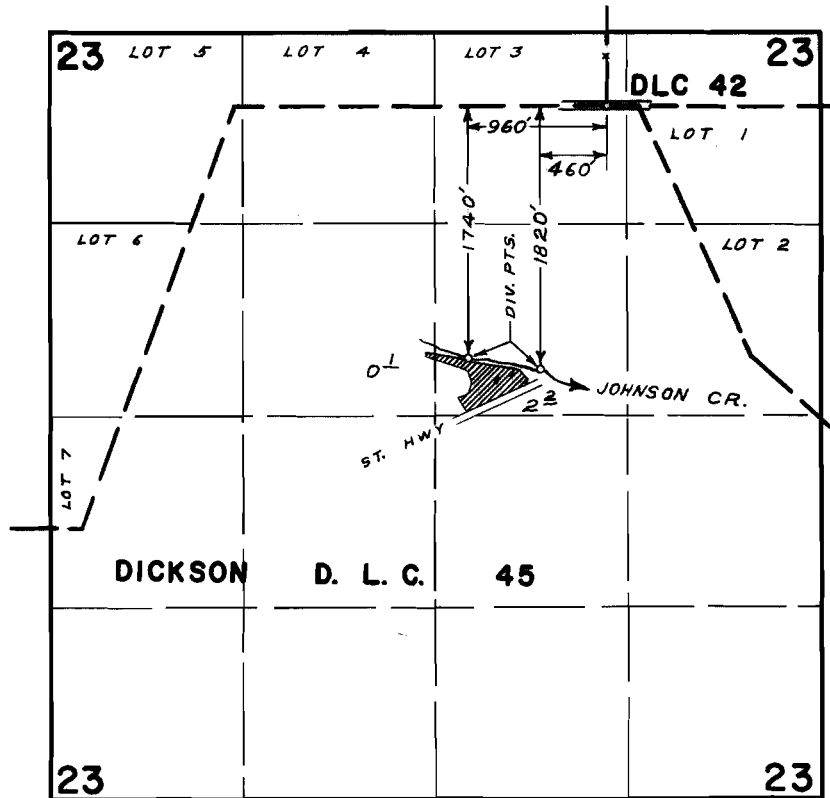

FINAL PROOF SURVEY UNDER

Application No. 40182 Permit No. 29950
IN NAME OF

W. A. McCOLLUM

Surveyed OCT. 7, 1968, by W. J. RUPPERT