


T.1S.R.5W.W.M.

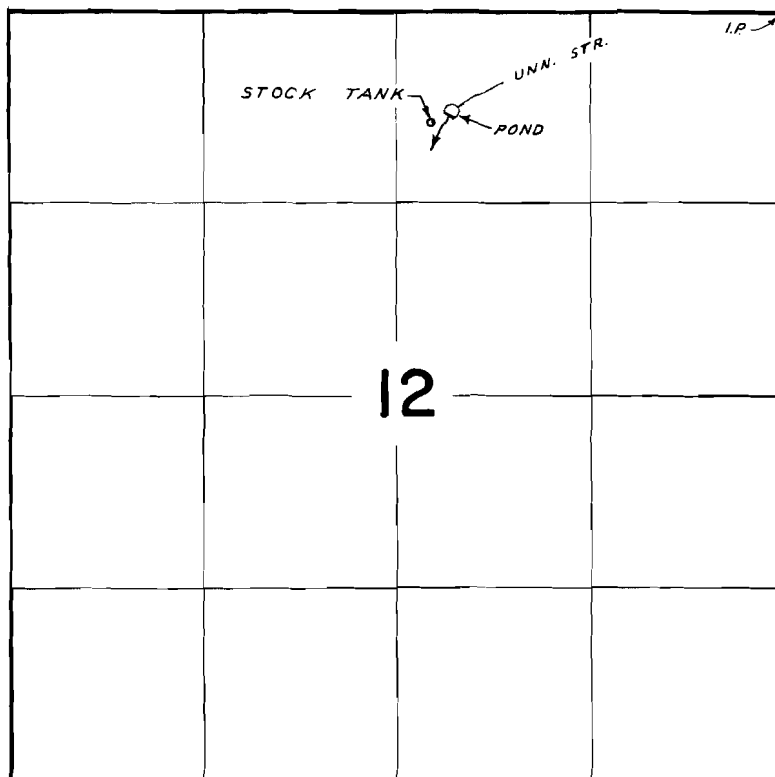

DAM LOCATED 710' S & 2290' W FROM NE COR. SEC. 12

FINAL PROOF SURVEY
UNDER

R-40185 R-4477
Application No. 40186 Permit No. 29951
IN NAME OF

PETER B. CASE

Surveyed OCT. 9 1968, by W. J. RUPPERT