


T. 1 S. R. 4 W. W. M.

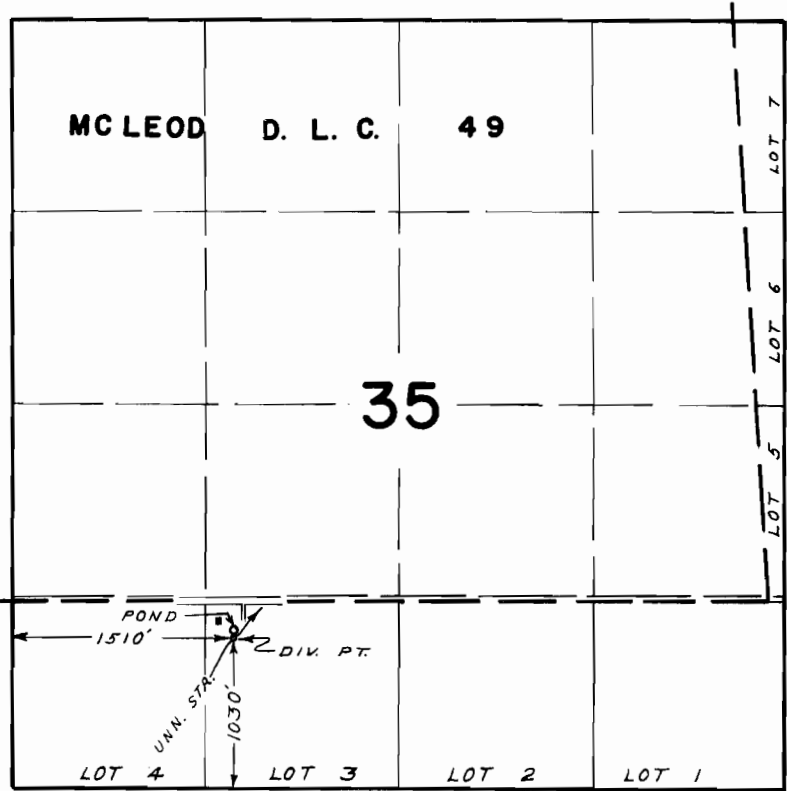

FINAL PROOF SURVEY
UNDER

Application No. **43331** Permit No. **32388**
IN NAME OF

DALLAS S. KIME

Surveyed **OCT. 9 1968**, by **W. J. RUPPERT**