


T. 7 S. R. 21 E. W.M.

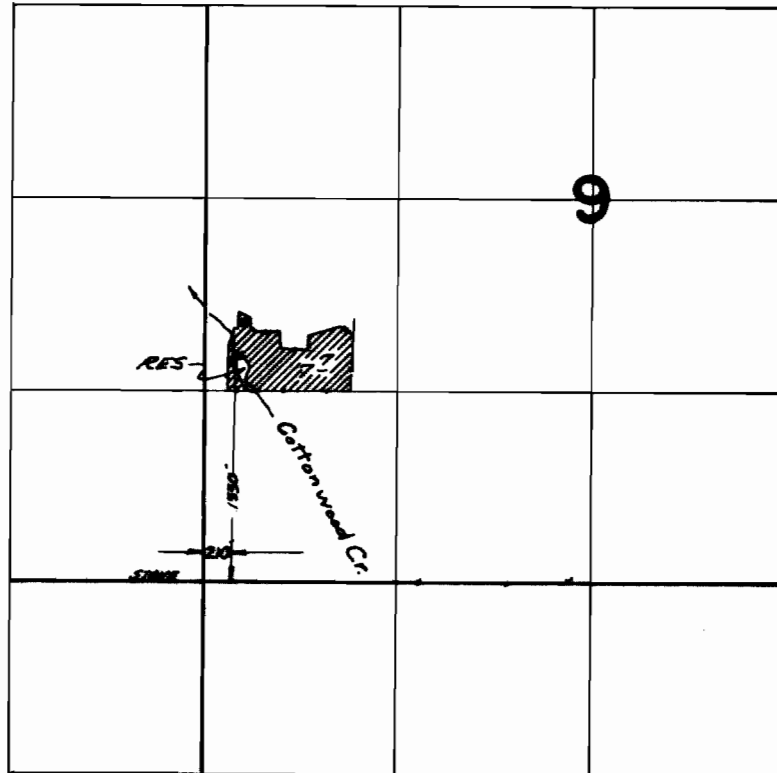

FINAL PROOF SURVEY
UNDER

34158 26934
Application No. R-34343 Permit No. R-2466
IN NAME OF

ALVA HUNT

Surveyed July 19, 1968, by V. Garner