


26934
36455

T.7 S. R.21 E. W.M.

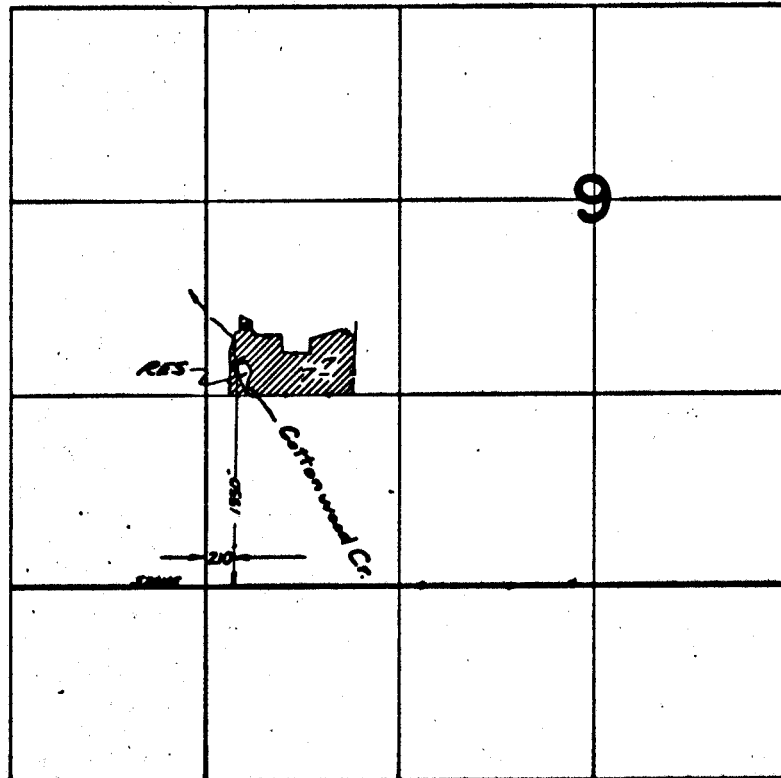

FINAL PROOF SURVEY
UNDER

Application No. 34158 Permit No. 26934
IN NAME OF

ALVA HUNT

Surveyed July 19, 1968, by K. Garner

1968-C