

WALTER FISH D.L.

34
T. 35. R. 1 E

CANBY
GARDENS


2340

Suppl to Cert 9840

2100 ft

S⁰ NE¹/₄ NW¹/₄ -
S⁰ SE¹/₄ NW¹/₄ -
Cert. 9840 -

Small unnamed
Creek, Tr. B.
Willamette R.

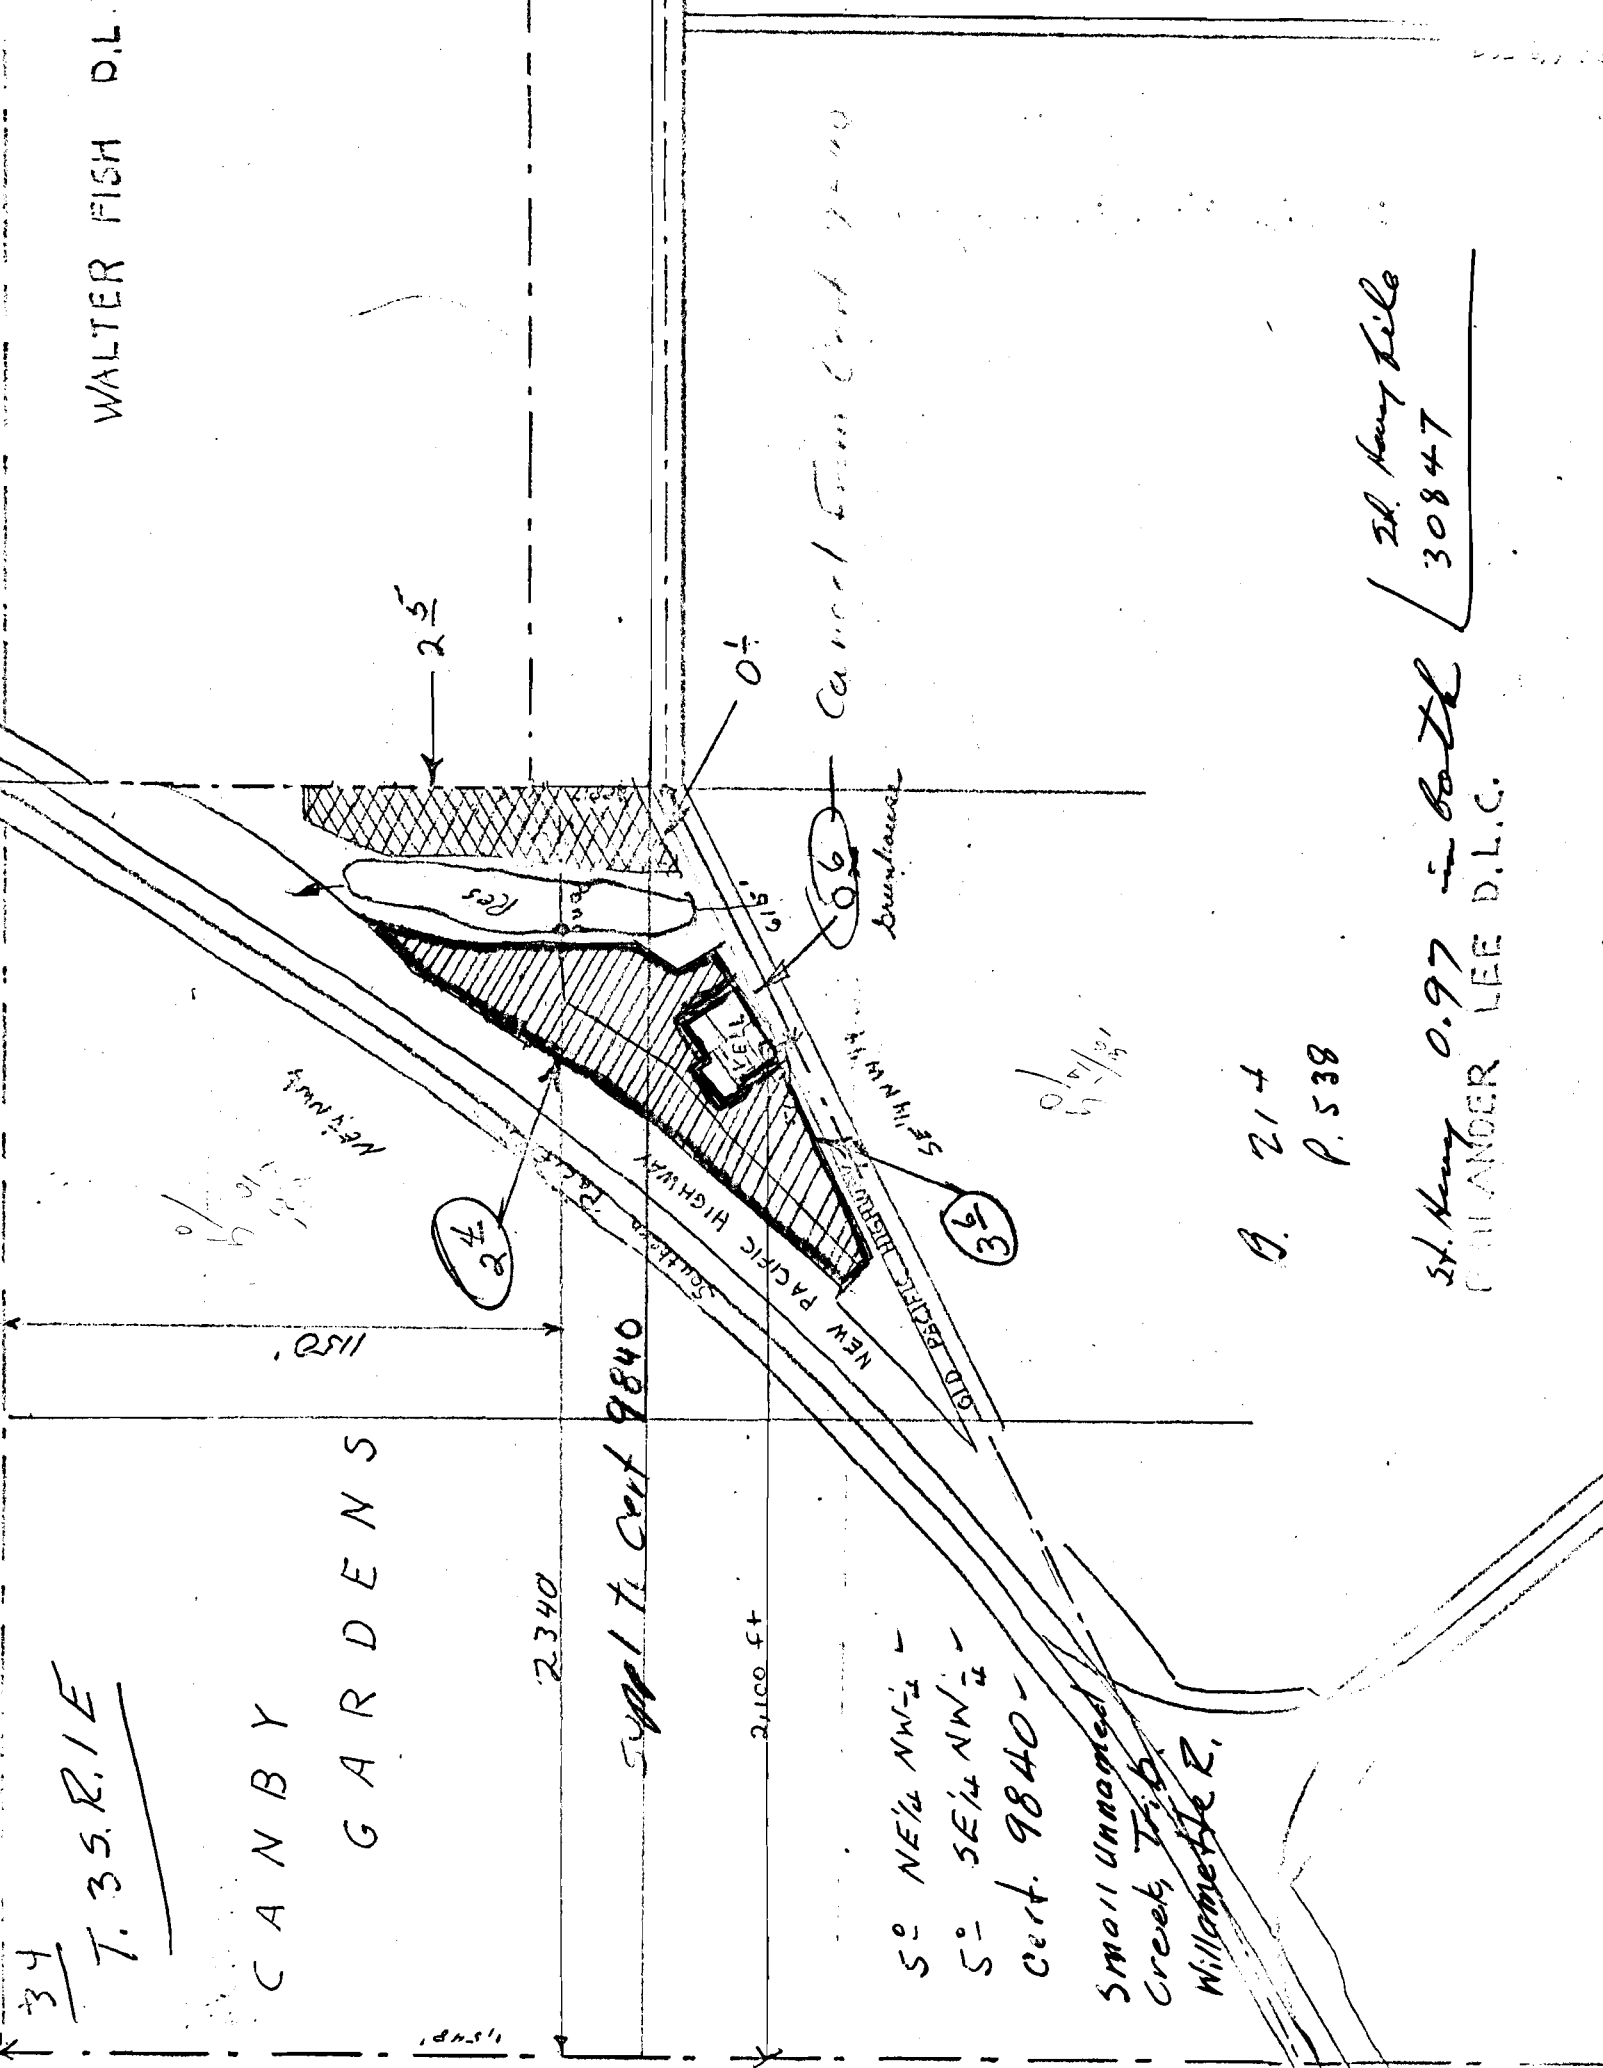

G. 214
P. 538

St. Mary 0.97 in both
CULLANDER LEE D.L.C.

St. Mary file
30847